

APR 01 1996

COMMISSION

STATE OF MICHIGAN
COUNTY OF KALAMAZOO
RECEIVED FOR RECORD

LAND CORNER RECORDATION CERTIFICATE

Filing Requirement of Act 74, Mich. P.A. 1970 '95 DEC 8 AM 10 55

For corners in KALAMAZOO Located In: _____ Corner Code # _____
 (County)

KALAMAZOO TWP.

1. Public Land Survey T 2S R 11W K5
 T _____ R _____
 T _____ R _____
 T _____ R _____

2. Property Controlling S _____ T _____ R _____
 in Section S _____ T _____ R _____

3. Miscellaneous S _____ T _____ R _____
 Property in Section S _____ T _____ R _____


James D. Hahn
CLERK-REGISTER

LIBER **1 1396**

Register of Deeds Stamp & File Number

4. Lot No. _____, Recorded Plat _____

5. Private Claims _____

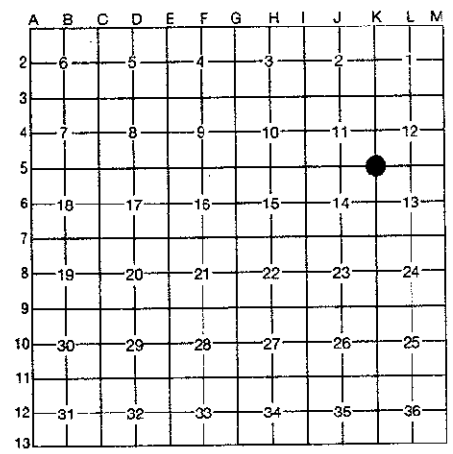

I, Gary D. Hahn, in a field survey on August 18, 19 95, do hereby certify that under requirements of P.A. 74, Michigan P.A. of 1970, the corner points mentioned in lines 1 and 2 above were in conformance with regulations and rules therefore as required in the current manual of survey instructions of the United States Department of the Interior, Bureau of Land Management or by a decree of a Court of Law and/or that the corner points mentioned in lines 3, 4 and 5 above were in conformance with the rules of the Michigan Board of Professional Surveyors or by a Decree of a Court of Law; established, re-established, monumented, re-monumented, recovered, found as expressed below:

NOTE: Not more than 4 corners, all in the same town and range, may be recorded on this certificate.

A. Description of original monument and accessories and/or subsequent restoration:

- 1829 Corner post established by U.S. Deputy Surveyor G. Risdon.
Accessories: W. Oak 24in S29°W 53.1k W. Oak 10in N64°W 13.1k
- 1885 Hodgman Set tile.
- 1931 KCRC topo notes: Tile Hickory N50°W 51.4' Maple S45°E 45.7' Oak S50°W 70.2'
- 1940 KCRC notes: Tile 18" Oak SW. 71.10' 18" Maple S.E.xE 45.74'
SE. cor. house NNW. 77.35' Elec. pole S. 33.2' Tele. pole NE. 16.2'

B. Description of corner evidence found and/or method applied in restoring or reestablishing corner:

Original monument and accessories not recovered.

Found 1/2" dia. steel rod in mon. box.


Found clay tile 1' below road surface. Tile is surrounded by stones. Tile is directly below 1/2" steel rod.

RATIFIED
BY KALAMAZOO COUNTY
REMONUMENTATION
PEER GROUP
 9-21-95 *J.D.H.*

C. Description of monument for corner and accessories established to perpetuate locating the position of the corner:

K5, Northwest corner section 13, T2S, R11W, Ratified by Kalamazoo County Remonumentation Peer Group on September 21, 1995. Tile is accepted as a careful and faithful perpetuation of the position of the original corner. Set 20" Harrison Monument directly over tile in a monument box.

- Set P.K. nail in 13" Maple N54°W 53.10'
- Set P.K. nail in P.P. N8°E 28.41'
- Set P.K. nail in 24" Maple S20°E 46.52'
- SE. cor. house foundation N20°W 77.21'

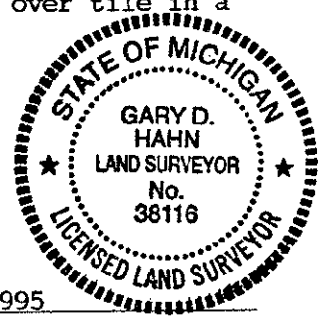

Signed by *Gary D. Hahn*
 Surveyor's Michigan License No. 38116

Date November 17, 1995