

AUG 22 1995

COMMISSION

STATE OF MICHIGAN  
COUNTY OF KALAMAZOO  
RECEIVED FOR RECORD

'95 FEB 9 PM 3 59

LAND CORNER RECORDATION CERTIFICATE

Filing Requirement of Act 74, Mich. P.A. 1970

For corners in CITY OF KALAMAZOO  
KALAMAZOO Located In:  
(County)

Corner Code #

- |                                      |                   |       |
|--------------------------------------|-------------------|-------|
| 1. Public Land Survey                | T 2 S R 11 W      | K-12  |
|                                      | T ___ R ___       | _____ |
|                                      | T ___ R ___       | _____ |
|                                      | T ___ R ___       | _____ |
| 2. Property Controlling in Section   | S ___ T ___ R ___ | _____ |
|                                      | S ___ T ___ R ___ | _____ |
| 3. Miscellaneous Property in Section | S ___ T ___ R ___ | _____ |
|                                      | S ___ T ___ R ___ | _____ |

*James [Signature]*  
CLERK-REGISTER

LIBER 1 PG 1273

Register of Deeds Stamp & File Number

4. Lot No. \_\_\_\_\_, Recorded Plat \_\_\_\_\_
5. Private Claims \_\_\_\_\_

A	B	C	D	E	F	G	H	I	J	K	L	M
2	6	5	4	3	2	1						
3												
4	7	8	9	10	11	12						
5												
6	18	17	16	15	14	13						
7												
8	19	20	21	22	23	24						
9												
10	30	29	28	27	26	25						
11												
12	31	32	33	34	35	36						
13												

I, Allen H. McMachen field survey on December 7, 19 94, do hereby certify that under requirements of P.A. 74, Michigan P.A. of 1970, the corner points mentioned in lines 1 and 2 above were in conformance with regulations and rules therefore as required in the current manual of survey instructions of the United States Department of the Interior, Bureau of Land Management or by a decree of a Court of Law and/or that the corner points mentioned in lines 3, 4 and 5 above were in conformance with the rules of the Michigan Board of Professional Surveyors or by a Decree of a Court of Law; established, re-established, monumented, re-monumented, recovered, found as expressed below:

NOTE: Not more than 4 corners, all in the same town and range, may be recorded on this certificate.

A. Description of original monument and accessories and/or subsequent restoration:

- 1827 - U.S. Government Survey; Set 1/4 Section Post  
Sugar 24" N. 76° W. 19 lks.  
Birch 5" S. 11° E. 35 lks.
- 1883 - F. Hodgeman, C.S., Found stake with brick around and marked stone over it at the intersection of fences. Put (1) brick at bottom and 2' earthen post over it with stones around the top.  
Beech 8" S. 02° E. 75 lks.  
Red Oak 4" N. 03° E. 48 1/2 lks.

B. Description of corner evidence found and/or method applied in restoring or reestablishing corner:

Found Clay Tile in monument box.


RATIFIED  
BY KALAMAZOO COUNTY  
REMONUMENTATION  
PEER GROUP

11/9/95  
*R.E.F.*

C. Description of monument for corner and accessories established to perpetuate locating the position of the corner:

Found Clay Tile is accepted as a careful and faithful perpetuation of the position of the original corner. Placed standard sleeve over existing Tile in monument box. Accessories:

- Nail in Utility Pole N. 50° W. 39.06'
- Nail in 18" Cherry NORTH 15.46'
- Southeast corner garage S. 60° W. 53.10'
- Northeast corner garage WEST 45.95'

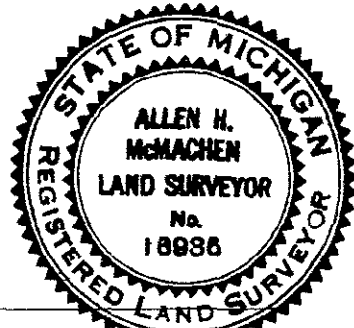

Signed by Allen H. McMachen  
Surveyor's Michigan License No. 16935

Date 2/9/95