

APR 6 1 1996
 COMMISSION

STATE OF MICHIGAN
 COUNTY OF KALAMAZOO
 RECEIVED FOR RECORD
 '95 DEC 8 AM 10 55

LAND CORNER RECORDATION CERTIFICATE
 Filing Requirement of Act 74, Mich. P.A. 1970

For corners in KALAMAZOO Located In: _____ Corner Code # _____
 (County)

KALAMAZOO TWP.

1. Public Land Survey T 2S R 11W _____ L5 _____
 T _____ R _____
 T _____ R _____
 T _____ R _____

2. Property Controlling S _____ T _____ R _____
 in Section S _____ T _____ R _____

3. Miscellaneous S _____ T _____ R _____
 Property in Section S _____ T _____ R _____

4. Lot No. _____, Recorded Plat _____

5. Private Claims _____

James Young
 CLERK-REGISTER
 LIBER 1 1398

Register of Deeds Stamp & File Number

A	B	C	D	E	F	G	H	I	J	K	L	M
2	6	5	4	3	2	1						
3												
4	7	8	9	10	11	12						
5												
6	18	17	16	15	14	13						
7												
8	19	20	21	22	23	24						
9												
10	30	29	28	27	26	25						
11												
12	31	32	33	34	35	36						
13												

I, Gary D. Hahn, in a field survey on August 16, 1995, do hereby certify that under requirements of P.A. 74, Michigan P.A. of 1970, the corner points mentioned in lines 1 and 2 above were in conformance with regulations and rules therefore as required in the current manual of survey instructions of the United States Department of the Interior, Bureau of Land Management or by a decree of a Court of Law and/or that the corner points mentioned in lines 3, 4 and 5 above were in conformance with the rules of the Michigan Board of Professional Surveyors or by a Decree of a Court of Law; established, re-established, monumented, re-monumented, recovered, found as expressed below:


NOTE: Not more than 4 corners, all in the same town and range, may be recorded on this certificate.

- A. Description of original monument and accessories and/or subsequent restoration:
- 1829 Quarter Corner established by U.S. Deputy Surveyor G. Risdon. Accessories: W. Oak 26in S79W 321k W. Oak 26in N71E 281k
 - 1864 F. Stimson Co. Sur. "Found gov. stake hole. Planted stake and brick"
 - 1878 E. Strong "Found corner" Sug 10 S_W 53 Sug 8 S_E 59
 - 1909 E. Strong "Found tile"
 - 1956 KCRC East Main St. Reconstruction plans - "Tile in C.I. box".
 - 19?? KCRC plans: Iron rod Maple 18" S20°W 37.2' Maple 16" S15°E 35.8' Hick. 14" N45°E 36.7'

B. Description of corner evidence found and/or method applied in restoring or reestablishing corner:
 Original monument and accessories not recovered.

Found 5/8" dia. X 10" long pipe in mon. box. Pipe had a 3" dia. X 4½" long threaded pipe around it. Found tile directly beneath 5/8" pipe. Tile had large chunks of brick around its sides.

RATIFIED
BY KALAMAZOO COUNTY
REMONUMENTATION
PEER GROUP
 9-21-95 *[Signature]*

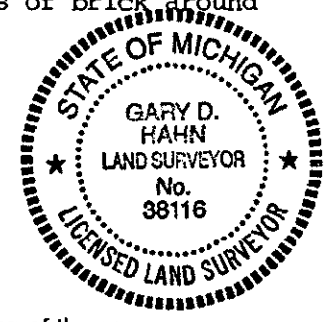

C. Description of monument for corner and accessories established to perpetuate locating the position of the corner:
 L5, North quarter corner section 13, T2S, R11W, Ratified by Kalamazoo County Remonumentation Peer Group on September 21, 1995. The tile location is accepted as a careful and faithful perpetuation of the position of the original corner. Removed tile (too shallow to set mon. over & too deep for sleeve) and replaced with a 20" Harrison monument in mon. box.

- SE. corner brick building N38°W 80.68'
- Most easterly portion of the northeast corner of pump house foundation S16°E 79.45'
- Set p.k. nail in 14" Maple N40°E 94.62'
- Set p.k. nail in 7" Maple S8°W 47.03'
- Fnd. M.D.O.T. nail w/ tab in P.P. N24°E 58.16'

Signed by *Gary D. Hahn* Date November 21, 1995
 Surveyor's Michigan License No. 38116