MAY 2 8 1997

## COMMISSION

LAND CORNER RECORDATION CERTIFICATE Filing Requirement of Act 74, Mich. P.A. 1970

2PAGE 093

Register of Deeds Stamp & File Number

4

3

5

6

8

9

10

11


For corners in Kalamazoo Twp. Corner Code # Kalamazoo Located In: L-09 R 11W 1. Public Land Survey R 2. Property Controlling in Section 3. Miscellaneous Property in Sec.

\_, Recorded Plat 5. Private Claims

in a field survey on Oct. 21, 19 96 do hereby state that under Robert E. Snell requirements of P.A. 74, Michigan P.A. of 1970, the corner points mentioned in lines 1 and 2 above were in conformance with regulations and rules therefore as required in the current manual of survey instructions of the United States Department of the Interior, Bureau of Land Management or by a decree of a Court of Law and /or that the corner points mentioned in lines 3, 4 and 5 above were in conformance with the rules of the Michigan Board of Land Surveyors or by a Decree of a Court of Law; established, re-established, monumented, recovered, found as expressed below:

NOTE: Not more than 2 corners, all in the same town and range, may be recorded, on this certificate.

RATIFIED BY KALAMAZOO COUNTY REMONUMENTATION

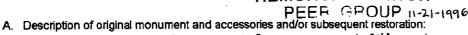

United States Government Surveyors; set 1/4 post.

Beech 12" S. 07° E. 13 lks.

Beech 7" N. 07° W. 22 lks.

Beech 7"

F. Stimson, County Surveyor; Sassafras stake from which a Beech 12" S. 88° E. 56 1ks.

Beech 10" S. 59½ W. 1864:

Hodgman, County Surveyor; found old stake at intersection of fences, N. 88½0 W. 1885: 56 lks. from stump of witnesses by Stimson in 1862. Bored 3' in white sand, filled the bottom with black earth and put 2' earthen post over: Beech 14" S. 28° E.  $62\frac{1}{2}$  Swamp Oak 14" N.  $64^{\circ}$  E.  $148\frac{1}{4}$  lks.

B. Description of corner evidence found and/or method applied in restoring or reestablishing corner:

Glen Wheaton, Surveyor; found tile at South 1/4 post, Section 24 in a survey of Statler's Acres (unrecorded).

1955: Wilkins & Wheaton Engr. Co.; found tile.

N. 60° E. N.  $05^{\circ}$  E. 35.15' 24" Maple 12" Hickory 12.75 s. 05° 12" Elm Dbl. Elm (8"&12") 23.2'

Found 3" round tile down about 1½' with top distressed. 1996:

C. Description of monument for corner and accessories established to perpetuate locating the position of the corner:

South 1/4 post, Section 24, T. 2 S., R. 11 W., ratified by the Kalamazoo County Remonumentation Program Peer Group on November 21, 1996 and is accepted as a careful and faithful perpetuation of the position of the original corner. Found 3" round tile as placed by F. Hodgman in 1885 remonumentation survey. Placed remonumentation sleeve over tile.

N. 25° E. 12" W. Cherry Southwest corner of Diversion Dam Fence (3" Steel Post) S. 45° E. South End of 5' Chain Link Fence center line 3" ct-cl 16d Nail in East Side 16d Nail in East Side 10.62' 93.921

Signed by Surveyor's Michigan License No

12-11-96