

REMONUMENTATION

STATE OF MICHIGAN
COUNTY OF KALAMAZOO
RECEIVED FOR RECORD

'95 AUG 31 AM 11 35

LAND CORNER RECORDATION CERTIFICATE
Filing Requirement of Act 74, Mich. P.A. 1970

For corners in <u>KALAMAZOO</u> (County)	Located In:	Corner Code #
CITY OF KALAMAZOO		
1. Public Land Survey	T <u>2</u> R <u>11</u>	<u>L11</u>
	T _____ R _____	_____
	T _____ R _____	_____
	T _____ R _____	_____
2. Property Controlling in Section	S _____ T _____ R _____	_____
	S _____ T _____ R _____	_____
3. Miscellaneous Property in Section	S _____ T _____ R _____	_____
	S _____ T _____ R _____	_____

Jamie Young
CLERK-REGISTER

LIBER 1 1347

Register of Deeds Stamp & File Number

4. Lot No. _____, Recorded Plat _____
5. Private Claims _____

A	B	C	D	E	F	G	H	I	J	K	L	M
2	6	5	4	3	2							
3												
4	7	8	9	10	11	12						
5												
6	18	17	16	15	14	13						
7												
8	19	20	21	22	23	24						
9												
10	30	29	28	27	26	25						
11												
12	31	32	33	34	35	36						
13												

I, GARY D. HAHN, in a field survey on APRIL 25, 19 95, do hereby certify that under requirements of P.A. 74, Michigan P.A. of 1970, the corner points mentioned in lines 1 and 2 above were in conformance with regulations and rules therefore as required in the current manual of survey instructions of the United States Department of the Interior, Bureau of Land Management or by a decree of a Court of Law and/or that the corner points mentioned in lines 3, 4 and 5 above were in conformance with the rules of the Michigan Board of Professional Surveyors or by a Decree of a Court of Law; established, re-established, monumented, re-monumented, recovered, found as expressed below:

NOTE: Not more than 4 corners, all in the same town and range, may be recorded on this certificate.

A. Description of original monument and accessories and/or subsequent restoration:

1829 Quarter section corner established by U.S. Deputy Surveyor Grange Risdon
Accessories: Beech 16in S73°W 21 lks.
Beech 7" N70°E 19 lks.

1956 Gove Associates, Inc. notes call for a tile - 30" Maple N45°E 38'
20" Walnut N45°W 50' Nail and cap 1' North

Date ? KCRC witness tie notes: Tile NE. cor bldg. S2°W 111.37' S. pole of two NW. 27.5'
Hydrant N75°W 152.41' 12" B.W. NW. 51.6'
20" Maple N45°E 37.6' Fence North


B. Description of corner evidence found and/or method applied in restoring or reestablishing corner:

Original corner and accessories not recovered.
Tile is believed to have been obliterated during construction of a sanitary sewer line in the center of Cork St.
Found 1" Rod 1 1/2' deep in a Mon. box in the center of Cork St. Rods location fits with witness tie above to hydrant N75°W 152.41'

**RATIFIED
BY KALAMAZOO COUNTY
REMONUMENTATION
PEER GROUP**
7-20-95 *R. S. S.*

C. Description of monument for corner and accessories established to perpetuate locating the position of the corner:
L11, North quarter corner Section 36, T2S, R11W, Ratified by kalamazoo County Remonumentation Peer Group on July 20, 1995. The location of the 1" Rod is accepted as the best available evidence of the position of the original corner. Removed rod and replaced with a 20" Harrison Monument in Mon. box.

Fence post (chain link) North 33.25'
Set P.K. nail in P.P. N40°E 43.04'
NE. Cor. conc. pad S20°W 52.19'
NW. Cor. conc. pad S35°E 47.24'

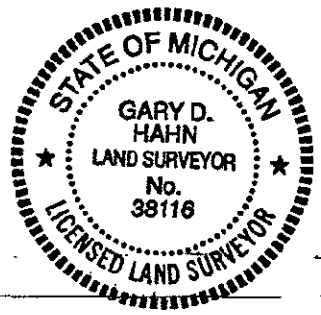

Signed by *Gary D. Hahn*
Surveyor's Michigan License No. 38116

Date 8-30-95