

SURVEY & REMONUMENTATION

AUG 22 1995

COMMISSION

STATE OF MICHIGAN
COUNTY OF KALAMAZOO
RECEIVED FOR RECORD
'95 AUG 1 PM 4 08

LAND CORNER RECORDATION CERTIFICATE
Filing Requirement of Act 74, Mich. P.A. 1970

For corners in

<u>Kalamazoo</u> (County)	Located In:	Corner Code #
Oshtemo Township	T 2 S R 12 W	B-9
1. Public Land Survey	T _____ R _____	_____
	T _____ R _____	_____
	T _____ R _____	_____
2. Property Controlling in Section	S _____ T _____ R _____	_____
	S _____ T _____ R _____	_____
3. Miscellaneous Property in Sec.	S _____ T _____ R _____	_____
	S _____ T _____ R _____	_____


James J. Jones
CLERK-REGISTER

LIBER 1 ■ 1312

Register of Deeds Stamp & File Number

4. Lot No. _____, Recorded Plat _____
5. Private Claims _____

I, Robert E. Snell, in a field survey on June 6, 19 95, do hereby certify that under requirements of P.A. 74, Michigan P.A. of 1970, the corner points mentioned in lines 1 and 2 above were in conformance with regulations and rules therefore as required in the current manual of survey instructions of the United States Department of the Interior, Bureau of Land Management or by a decree of a Court of Law and/or that the corner points mentioned in lines 3, 4 and 5 above were in conformance with the rules of the Michigan Board of Land Surveyors or by a Decree of a Court of Law; established, re-established, monumented, re-monumented, recovered, found as expressed below:

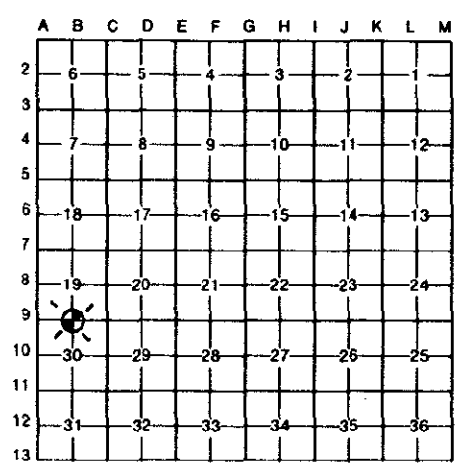

NOTE: Not more than 4 corners, all in the same town and range, may be recorded on this certificate.

- A. Description of original monument and accessories and/or subsequent restoration:
 1829: United States Government Survey; 1/4 Section Corner on a White Oak 10"
 1871: Ed Strong, County Surveyor; Removed stub of old 1/4 Section Corner Tree and in its place [] stake, stone and old iron and marked
 Wh. Oak 14" North 57 1/2° East 61 Lks
- B. Description of corner evidence found and/or method applied in restoring or reestablishing corner:
 1995: Found stone with drill hole in monument box with old axe head on North side of stone. A 1/2" Iron rod was found 0.23' East and 0.66' South of drilled stone.

RATIFIED
BY KALAMAZOO COUNTY
REMONUMENTATION
PEER GROUP
7-20-95
R.E.S.

- C. Description of monument for corner and accessories established to perpetuate locating the position of the corner:
 B-9 North 1/4 Post Section 30, T. 2 S., R. 12 W., Ratified by the Kalamazoo County Remonumentation Program Peer Group on July 20, 1995 and is accepted as a careful and faithful perpetuation of the position of the original corner. Found stone with drill mark in top and old axe head (old iron) as called for in a survey by Ed Strong in 1871. Lowered stone and placed a 20" Harrison monument and monument box over stone.
- | | | | |
|-------------------------------|------------------|----------------|---------|
| Found | 1/2" Cap/Iron | North | |
| Exist. Nail/Tab in South Side | 50" Oak | North 66° East | 58.03' |
| Placed | 18" x 1/2" Rerod | South | 30.10' |
| Exist. Nail/Tab in South Side | Telephone Pole | South 74° West | 146.68' |

Signed by *Robert E. Snell* Date 7-26-95
Surveyor's Michigan License No. 9734