

1995

STATE OF MICHIGAN
COUNTY OF KALAMAZOO
RECEIVED FOR RECORD

'95 AUG 31 AM 11 35

LAND CORNER RECORDATION CERTIFICATE
Filing Requirement of Act 74, Mich. P.A. 1970

For corners in
KALAMAZOO
(County)

Located In:

Corner Code #

OSHTEMO TWP.


1. Public Land Survey	T <u>2</u> R <u>12</u>	<u>C11</u>
	T ___ R ___	_____
	T ___ R ___	_____
	T ___ R ___	_____
2. Property Controlling in Section	S ___ T ___ R ___	_____
	S ___ T ___ R ___	_____
3. Miscellaneous Property in Section	S ___ T ___ R ___	_____
	S ___ T ___ R ___	_____

Jamie Jones
CLERK-REGISTER

LIBER **1 1348**

Register of Deeds Stamp & File Number

- 4. Lot No. _____, Recorded Plat _____
- 5. Private Claims _____

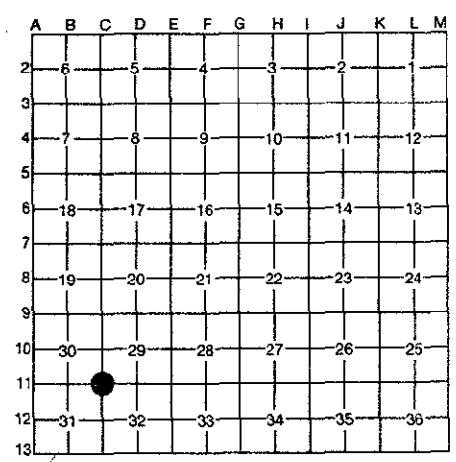

I, GARY D. HAHN, in a field survey on MAY 3, 1995, do hereby certify that under requirements of P.A. 74, Michigan P.A. of 1970, the corner points mentioned in lines 1 and 2 above were in conformance with regulations and rules therefore as required in the current manual of survey instructions of the United States Department of the Interior, Bureau of Land Management or by a decree of a Court of Law and/or that the corner points mentioned in lines 3, 4 and 5 above were in conformance with the rules of the Michigan Board of Professional Surveyors or by a Decree of a Court of Law; established, re-established, monumented, re-monumented, recovered, found as expressed below:

NOTE: Not more than 4 corners, all in the same town and range, may be recorded on this certificate.

A. Description of original monument and accessories and/or subsequent restoration:

1830 Corner post established by U.S. Deputy Surveyor Geo. W. Harrison
 Accessories: Bl. Oak 8 N65°E 541.
 Bl. Oak 10 S25°W 771.

1988 LCRC Thomas Chettleburgh RLS-16036 "Found railroad spike on tree line & fence line to South" 20" Hickory S50°E 52.10'
 Tele. Pole S44°E 34.16'
 19" Oak S3°W 56.00'
 42" Oak N38°W 33.80'

B. Description of corner evidence found and/or method applied in restoring or reestablishing corner:

Original corner accessories not recovered.

Found railroad spike in asphalt road whose location fits above Chettleburgh ties.


Found 8" x 8" x 11" stone pointed up with small stones around it 30" deep in sandy soil. Stone is 1.45' West and 0.3' North of railroad spike.

RATIFIED
BY KALAMAZOO COUNTY
REMONUMENTATION
PEER GROUP
 7-20-95 *R. E. F.*

C. Description of monument for corner and accessories established to perpetuate locating the position of the corner:

C11, Southeast corner Section 30, T2S, R12W, Ratified by Kalamazoo County Remonumentation Peer Group on July 20, 1995. Location of stone is accepted as the best available evidence of the position of the original corner. Set 20" Harrison Monument and Mon. box over stone.

Fnd. nail with tab in 43" Walnut N38°W 32.73'
 Set P.K. nail in 25" Walnut N58°W 56.81'
 Fnd. nail with tab & P.K. nail over it in P.P. S42°E 35.47'
 Set P.K. nail in wood fence post S16°W 30.07'

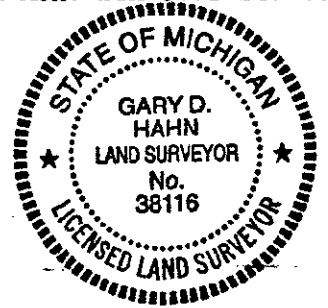

Signed by *Gary D. Hahn*

Date 8-30-95

Surveyor's Michigan License No. 38116