

APR 01 1996

LIBER 1 1443


COMMISSION

LAND CORNER RECORDATION CERTIFICATE
Filing Requirement of Act 74, Mich. P.A. 1970

For corners in Kalamazoo (County) Located In: Oshtemo Twp. Corner Code # F-11
1. Public Land Survey T 2 S. R 12 W.
2. Property Controlling in Section S T R
3. Miscellaneous Property in Section S T R

STATE OF MICHIGAN COUNTY OF KALAMAZOO RECEIVED FOR RECORD 96 JUN 29 PM 2 15 Register of Deeds Stamp & File Number

4. Lot No. , Recorded Plat
5. Private Claims

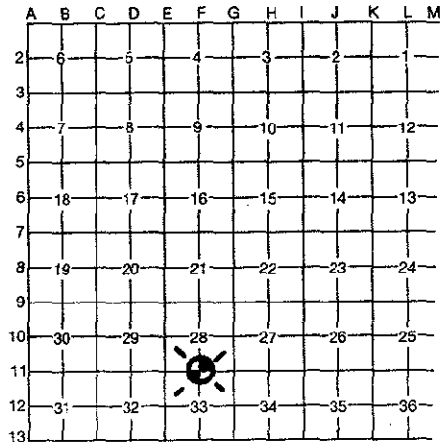

I, Robert E. Snell, in a field survey on June 13, 1992, do hereby certify that under requirements of P.A. 74, Michigan P.A. of 1970, the corner points mentioned in lines 1 and 2 above were in conformance with regulations and rules therefore as required in the current manual of survey instructions of the United States Department of the Interior, Bureau of Land Management or by a decree of a Court of Law and/or that the corner points mentioned in lines 3, 4 and 5 above were in conformance with the rules of the Michigan Board of Professional Surveyors or by a Decree of a Court of Law; established, re-established, monumented, re-monumented, recovered, found as expressed below:

NOTE: Not more than 4 corners, all in the same town and range, may be recorded on this certificate.

A. Description of original monument and accessories and/or subsequent restoration:

1829: United States Government Surveyors; set 1/4 Section post.
R. Oak 16" N. 04° W. 59 lks.
W. Oak 4" S. 10° W. 25 lks.

1865: F. Stimson, County Surveyor; recorded in former survey.

1911: E. Strong, County Surveyor; Frie and Gibbs Plat, found charcoal and stake point and stones. Set Sassafras stake.
Sassafras 7" N. 87° E. 27 lks.

B. Description of corner evidence found and/or method applied in restoring or reestablishing corner:

1969: Wilkins & Wheaton Engineering Company; found stone and charcoal in East and West fence.

Twin Sassafras Northwest 1.5'

1992: Found stone in remains of East and West fence line.

6" W. Oak S. 75° E. 7.10'
6" W. Cherry N. 40° E. 30.04'

North and South fence corner with East and West fence 200' West
No North or South occupation at North 1/4 post
Surrounded by Sassafras Trees

RATIFIED BY KALAMAZOO COUNTY REMONUMENTATION PEER GROUP 12-14-95

C. Description of monument for corner and accessories established to perpetuate locating the position of the corner:

F-11: North 1/4 post of Section 33, T. 2 S., R. 12 W., ratified by Kalamazoo County Remonumentation Program Peer Group on December 14, 1995 and is accepted as a careful and faithful perpetuation of the position of the original corner. Found stone as set by F. Stimson in 1865 and found by E. Strong in 1911 surveys. Removed stone and placed a 30" Harrison Monument in its place.

Nail in Southeast base 6" Wild Cherry N. 38° E. 30.07'
Nail in Northeast base 6" Oak S. 44° E. 7.09'
PK Nail in West side 14" Sassafras South 4.20'
PK Nail in East side Double 14" Sassafras N. 20° W. 1.49'

Signed by Robert E. Snell
Surveyor's Michigan License No. 9734

Date 1-26-96