

SURVEY 277

REMONUMENTATION

AUG 22 1995

LAND CORNER RECORDATION CERTIFICATE

Filing Requirement of Act 74, Mich. P.A. 1970

For corners in

COMMISSION

Kalamazoo (County)

Located In:

Corner Code #

Oshtemo Township

1. Public Land Survey	T	2	S	R	12	W	H-13
	T		R				
	T		R				
	T		R				
2. Property Controlling in Section	S		T		R		
	S		T		R		
3. Miscellaneous Property in Sec.	S		T		R		
	S		T		R		

- 4. Lot No. _____, Recorded Plat _____
- 5. Private Claims _____

STATE OF MICHIGAN
 COUNTY OF KALAMAZOO
 RECEIVED FOR RECORD
 95 APR 24 PM 3 32
 CLERK - REGISTER

Register of Deeds Stamp & File Number

A	B	C	D	E	F	G	H	I	J	K	L	M
2	6	5	4	3	2	1						
3												
4	7	8	9	10	11	12						
5												
6	18	17	16	15	14	13						
7												
8	19	20	21	22	23	24						
9												
10	30	29	28	27	26	25						
11												
12	31	32	33	34	35	36						
13												

I, Robert E. Snell, in a field survey on November 7, 19 94, do hereby certify that under requirements of P.A. 74, Michigan P.A. of 1970, the corner points mentioned in lines 1 and 2 above were in conformance with regulations and rules therefore as required in the current manual of survey instructions of the United States Department of the Interior, Bureau of Land Management or by a decree of a Court of Law and/or that the corner points mentioned in lines 3, 4 and 5 above were in conformance with the rules of the Michigan Board of Land Surveyors or by a Decree of a Court of Law; established, re-established, monumented, re-monumented, recovered, found as expressed below:

NOTE: Not more than 4 corners, all in the same town and range, may be recorded on this certificate.

A. Description of original monument and accessories and/or subsequent restoration:


1827: U.S. Government Survey; Set 1/4 Section Post.
 Wh. Oak 8" North 32° East 76 Lks
 Wh. Oak 10" North 48 2/3° West 125 Lks

1875: Ed Strong, County Surveyor; Hickory 8" North 20° East 23 Lks
 Stone and crockery from two U.S. Stumps.

B. Description of corner evidence found and/or method applied in restoring or reestablishing corner:

1994: Found stone and crockery in process of sewer construction.

RATIFIED
 BY KALAMAZOO COUNTY
 REMONUMENTATION
 PEER GROUP
 4-20-95

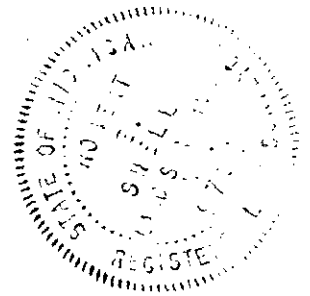

C. Description of monument for corner and accessories established to perpetuate locating the position of the corner:

H-13 South 1/4 Post Section 34, T. 2 S., R. 12 W.; Ratified by the Kalamazoo County Remonumentation Program Peer Group on April 20, 1995. Found stone and crockery as called for in 1875 survey by Ed Strong, County Surveyor and is accepted as a careful and faithful perpetuation of the position of the original corner. Placed a 20" Harrison monument and monument box after road reconstruction was completed. Stone may have been removed.
 Bound is 2' North of CL "N" Avenue as relocated

PK Nail in West Side	12" Triple Oak	North 55° East	46.58'
PK Nail in East Side	12" Oak	South 15° West	75.86'
PK Nail in East Side	12" Oak	South 20° East	84.56'
Exist. Nail/Tab in West Side	Power Pole	North 18° East	65.52'

Signed by Robert E. Snell
 Surveyor's Michigan License No. 9734

Date 4-24-95