



LC-000066

Page: 1 of 1
11/18/1999 02:22P
Bk-2 Pg-519

LAND CORNER RECORDATION CERTIFICATE
Filing Requirement of Act 74, Mich. P.A. 1970

For corners in

Form with fields for County (Kalamazoo), Township (Climax), and various survey types (Public Land Survey, Property Controlling, etc.) with corresponding T/R and S/T/R codes.

SURVEY & REMONUMENTATION

FEB 08 2000

SECTION

Register of Deeds Stamp & File Number

I, Gary D. Hahn, in a field survey on August 10, 1999 do hereby state that under requirements of P.A. 74, Michigan P.A. of 1970, the corner points mentioned in lines 1 and 2 above were in conformance with regulations and rules therefore as required in the current manual of survey instructions of the United States Department of the Interior, Bureau of Land Management or by a decree of a Court of Law and /or that the corner points mentioned in lines 3, 4 and 5 above were in conformance with the rules of the Michigan Board of Land Surveyors or by a Decree of a Court of Law; established, re-established, monumented, recovered, found as expressed below:

NOTE: Not more than 2 corners, all in the same town and range, may be recorded on this certificate.


A. Description of original monument and accessories and/or subsequent restoration:

Corner not established during G.L.O. Survey.

1861, Volume 6, Page 413 "Stone. Stimson January 10, 1861"

1872 - F. Hodgeman - "At the 1/4 post of Sect.19, Climax measured south from stone 1/4 post Sect. 24, Pavilion 115 1/2 lks. and planted stake for 1/4 sec. cor. sec. 19 Climax"

1956 - K.C.R.C. 36th Street construction plans call for an iron.

- K.C.R.C. Witness Tie Book: (W) Fd. stake + brick pl. iron (W) 10" Maple SE. 48.9 (W) Walk W. 33.77 (W) SW. Cor. Hse. NE. 67.16 (W) Walk inter. NE. 42.20 (W) Drilled Stone N 76.20

RATIFIED BY KALAMAZOO COUNTY REMONUMENTATION PEER GROUP 9-23-1999

B. Description of corner evidence found and/or method applied in restoring or reestablishing corner:

Found a 1/2" diameter 18" long rebar in a monument box. Excavated a 5' x 5' x 4' deep hole. Went through 29" of asphalt and subbase before hitting clean sand. Found no stone. May have been lost to a storm sewer line. Measured north 76.00 feet to a found capped iron in a monument box (RLS 9734). The position of the Pavilion corner iron has been ratified by the Kalamazoo County Remonumentation Peer Group and is awaiting the placement of a Harrison Monument.

C. Description of monument for corner and accessories established to perpetuate locating the position of the corner:


A-8, West Quarter Post Section 19, Town 3 South, Range 9 West. Ratified by Kalamazoo County Remonumentation Peer Group on September 23, 1999. The position of the found 1/2" rebar is accepted as the best available evidence of the position of the original corner. Set a 20" Harrison Monument in a Monument Box in place of the 1/2" diameter rebar.

Witness Ties:

- Found P.K. nail in power pole N 25 ° W 59.14' Set P.K. nail in power pole N 18 ° E 59.62' Found P.K. nail in power pole N 65 ° E 49.07' Found P.K. nail in power pole S 39 ° E 35.84' Back of concrete walk West 33.77' Southwest corner of house Northeast 67.03' Intersection of concrete walk Northeast 42.00'

Signed by [Signature] Surveyor's Michigan License No. 38116

Date 11/8/99

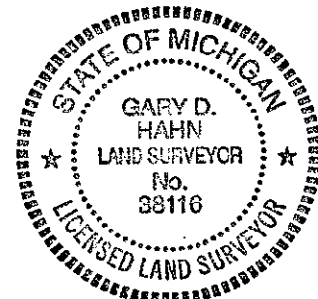

FORM APPROVED BY MICHIGAN STATE BOARD OF PROFESSIONAL SURVEYORS, JAN. 28, 1971

REVISED MAY 14, 1975 REVISED JAN., 1983 REVISED