

**SURVEY &
REMONUMENTATION**

FEB 18 1994

COMMISSION

LAND CORNER RECORDATION CERTIFICATE

Filing Requirement of Act 74, Mich. P.A. 1970

STATE OF MICHIGAN
COUNTY OF KALAMAZOO
RECEIVED FOR RECORD

'93 NOV 29 PM 2 21

For corners in

<u>Kalamazoo</u> (County)	Located In:	Corner Code #
Climax Township		
1. Public Land Survey	T <u>3</u> S <u>R9</u> W	<u>E-9</u>
	T _____ R _____	_____
	T _____ R _____	_____
	T _____ R _____	_____
2. Property Controlling in Section	S _____ T _____ R _____	_____
	S _____ T _____ R _____	_____
3. Miscellaneous Property in Sec.	S _____ T _____ R _____	_____
	S _____ T _____ R _____	_____
4. Lot No. _____, Recorded Plat _____		
5. Private Claims _____		


Jamaal DeYoung
CLERK-REGISTER

LIBER 1 PG 1036

Register of Deeds Stamp & File Number

I, John G. Kester, in a field survey on August 9, 19 93, do hereby certify that under requirements of P.A. 74, Michigan P.A. of 1970, the corner points mentioned in lines 1 and 2 above were in conformance with regulations and rules therefore as required in the current manual of survey instructions of the United States Department of the Interior, Bureau of Land Management or by a decree of a Court of Law and/or that the corner points mentioned in lines 3, 4 and 5 above were in conformance with the rules of the Michigan Board of Land Surveyors or by a Decree of a Court of Law; established, re-established, monumented, re-monumented, recovered, found as expressed below:

NOTE: Not more than 4 corners, all in the same town and range, may be recorded on this certificate.

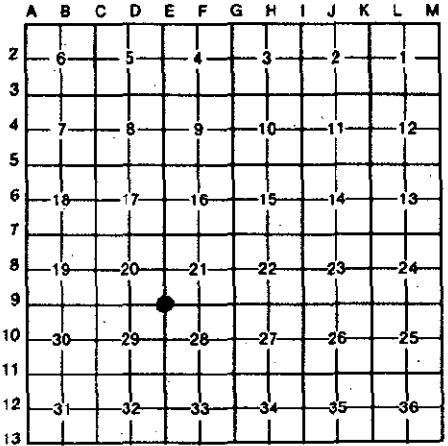

A. Description of original monument and accessories and/or subsequent restoration:
 Corner Post established by U S Government Deputy Surveyor Robert Clark, 1826,
 Accessories: Sugar 15 S5W 20, Sugar 15 S83E 15½.
 Remonumentation by F. Hodgeman, 1883, Found Large Boulder set for Corner and witness trees of resurvey standing.

B. Description of corner evidence found and/or method applied in restoring or reestablishing corner:
 Original Corner and Accessories not recovered.
 Found ½" Iron over ½" Pipe with small Stones around.
 Found Large Boulder, 22" below surface 6.20' South and 2.70' East of ½" Pipe, believed to be same as called for in 1883 Remonumentation by F. Hodgeman.

**RATIFIED
BY KALAMAZOO COUNTY
REMONUMENTATION
PEER GROUP
10-6-93**

C. Description of monument for corner and accessories established to perpetuate locating the position of the corner:
 E-9, Corner of Sections 20, 21, 28 & 29, T3S-R9W, Ratified by Kalamazoo County Remonumentation Program Peer Group on October 6, 1993. Found ½" Iron over ½" Pipe with Stones around - Found Large Boulder, 6.20' South and 2.70' East of Pipe, called for in 1883 Remonumentation by F. Hodgeman and is accepted as a careful and faithful perpetuation of the Original Corners position. Removed ½" Iron, ½" Pipe with Stones around. Placed 20" Harrison Monument above high point on Large Boulder and placed Monument Box over Corner.

- Set P.K. Nail in P.P. S50W 55.35'
- Set P.K. Nail in P.P. N50W 63.73'
- Set P.K. Nail in P.P. N45E 56.34'
- Set P.K. Nail in 22" Poplar S45E 36.65'

Signed by *John G. Kester* Date 11-26-93

Surveyor's Michigan License No. 16046
 Kalamazoo County Road Commission