

SURVEY & REMONUMENTATION

7
2

AUG 06 1996

COMMISSION


LAND CORNER RECORDATION CERTIFICATE
Filing Requirement of Act 74, Mich. P.A. 1970

For corners in Kalamazoo (County) Located in: _____ Corner Code # _____
Climax Twp.

1. Public Land Survey	T <u>3</u> S. R <u>9</u> W.	<u>G-03</u>
	T _____ R _____	_____
	T _____ R _____	_____
	T _____ R _____	_____
2. Property Controlling in Section	S _____ T _____ R _____	_____
	S _____ T _____ R _____	_____
3. Miscellaneous Property in Section	S _____ T _____ R _____	_____
	S _____ T _____ R _____	_____

4. Lot No. _____, Recorded Plat _____
 5. Private Claims _____

STATE OF MICHIGAN
 COUNTY OF KALAMAZOO
 RECEIVED FOR RECORD
 '96 MAY 23 PM 1 47
 CLERK - REGISTER
 LIBER 1 PAGE 1491
 Register of Deeds Stamp & File Number

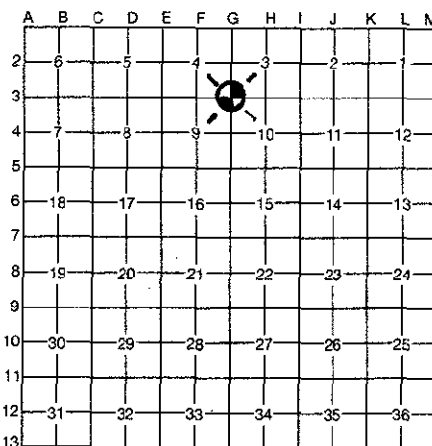

I, Robert E. Snell, in a field survey on April 18, 19 96, do hereby certify that under requirements of P.A. 74, Michigan P.A. of 1970, the corner points mentioned in lines 1 and 2 above were in conformance with regulations and rules therefore as required in the current manual of survey instructions of the United States Department of the Interior, Bureau of Land Management or by a decree of a Court of Law and/or that the corner points mentioned in lines 3, 4 and 5 above were in conformance with the rules of the Michigan Board of Professional Surveyors or by a Decree of a Court of Law; established, re-established, monumented, re-monumented, recovered, found as expressed below:

NOTE: Not more than 4 corners, all in the same town and range, may be recorded on this certificate.

A. Description of original monument and accessories and/or subsequent restoration:

- 1826: United States Government Surveyors; set post, corner to Sections 3, 4, 9 and 10.
 Burr Oak 12" N. 59° E. 49 lks.
 Burr Oak 5" S. 67½° W. 47½ lks.
- 1883: F. Hodgman, County Surveyor; replaced stake and stones of former survey with 3' earthen post, stones around, one U.S. witness and two witness trees of resurvey standing.

B. Description of corner evidence found and/or method applied in restoring or reestablishing corner:

- 1971: Acro Engineering Co.; found tile 16" deep.
 1996: Found ½" x 8" long iron bar over 3" round tile 32" deep.

RATIFIED
BY KALAMAZOO COUNTY
REMONUMENTATION
PEER GROUP
 5-16-1996 *R.E.S.*

C. Description of monument for corner and accessories established to perpetuate locating the position of the corner:

G-03: Southwest corner Section 3, T. 3 S., R. 9 W., Ratified by the Kalamazoo County Remonumentation Program Peer Group on May 16, 1996, and is accepted as a careful and faithful perpetuation of the position of the original corner. Found 3" round tile as set by F. Hodgman, County Surveyor in 1883 remonumentation survey. Placed 20" Harrison Monument over tile in monument box.

- | | | |
|--|-----------|---------|
| PK Nail on West Side of 20" Choke Cherry | S. 40° E. | 47.05' |
| PK Nail on West Side of 18" Twin Pin Oak | S. 20° E. | 68.82' |
| PK Nail on East Side of 22" Twin Oak | S. 20° W. | 79.30' |
| PK Nail on North Side of 18" Oak | S. 80° W. | 112.93' |

Signed by Robert E. Snell
 Surveyor's Michigan License No. 9734

Date 5-23-96