

**SURVEY & REMONUMENTATION**

AUG 06 1996

COMMISSION

**LAND CORNER RECORDATION CERTIFICATE**  
Filing Requirement of Act 74, Mich. P.A. 1970

STATE OF MICHIGAN  
COUNTY OF KALAMAZOO  
RECEIVED FOR RECORD

96 MAY 14 AM 8 54

For corners in  
Kalamazoo  
(County)  
Climax Township

Located In:

Corner Code #


1. Public Land Survey	T <u>3</u> S. R <u>9</u> W.	<u>G-10</u>
	T _____ R _____	_____
	T _____ R _____	_____
	T _____ R _____	_____
2. Property Controlling in Section	S _____ T _____ R _____	_____
	S _____ T _____ R _____	_____
3. Miscellaneous Property in Section	S _____ T _____ R _____	_____
	S _____ T _____ R _____	_____

*James J. [Signature]*  
CLERK - REGISTER

LIBER 1 PAGE 1487

Register of Deeds Stamp & File Number

4. Lot No. \_\_\_\_\_, Recorded Plat \_\_\_\_\_  
5. Private Claims \_\_\_\_\_

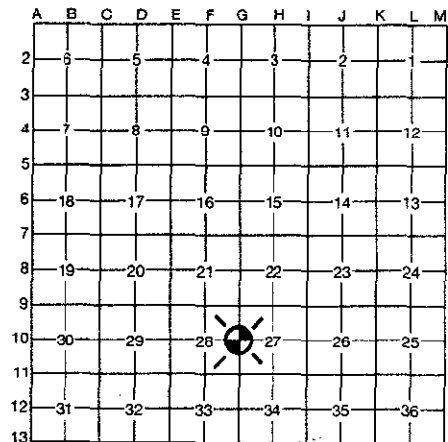

I, Robert E. Snell, in a field survey on February 23, 19 96, do hereby certify that under requirements of P.A. 74, Michigan P.A. of 1970, the corner points mentioned in lines 1 and 2 above were in conformance with regulations and rules therefore as required in the current manual of survey instructions of the United States Department of the Interior, Bureau of Land Management or by a decree of a Court of Law and/or that the corner points mentioned in lines 3, 4 and 5 above were in conformance with the rules of the Michigan Board of Professional Surveyors or by a Decree of a Court of Law; established, re-established, monumented, re-monumented, recovered, found as expressed below:

**NOTE: Not more than 4 corners, all in the same town and range, may be recorded on this certificate.**

**A. Description of original monument and accessories and/or subsequent restoration:**

1826: United States Government Surveyors; set 1/4 Section post.

Sugar 12" N. 79° E. 18½ lks.  
Beech 13" N. 35° W. 9 lks.

1883: F. Hodgman, County Surveyor; found old stake in the center of the road and in line with a fence running South. Said by Aaron Soules and C. Williams to have been kept on the Section line. Bored 3', filled bottom with brick and put 2' earthen post over to 6 inches below surface of road with stone around and noted without marking.

Blk. Walnut 12" S. 06° W. 143 lks. Cherry 6" N. 24½° E. 58 lks.

**B. Description of corner evidence found and/or method applied in restoring or reestablishing corner:**

1988: D. Peabody, R.L.S. #25866, L.C.R.C. L-1, P-896 - Tile in monument box.

Bell (Telephone) Box North 39.0'  
16" Walnut S. 30° W. 29.0'  
Bell (Telephone) Box South 21.5'  
18" Walnut N. 70° W. 78.3'  
Centerline Road North 7.0'±

1996: Found "mushroom head" tile in monument box 3" below surface of gravel road.

**RATIFIED**  
**BY KALAMAZOO COUNTY**  
**REMONUMENTATION**  
**PEER GROUP**

**C. Description of monument for corner and accessories established to perpetuate locating the position of the corner:**

G-10: West ¼ post, Section 27, T. 3 S., R. 9 W., Ratified by the Kalamazoo County Remonumentation Program Peer Group on April 18, 1996 and is accepted as a careful and faithful perpetuation of the position of the original corner. Found 3" round tile with "mushroom head" in Monument box. Tile placed by F. Hodgman in a 1883 Remonumentation survey. Removed head and placed Remonumentation sleeve over tile.

PK Nail in East Side 24" Walnut S. 30° W. 29.96'  
PK Nail in North Side 24" Walnut S. 70° W. 64.40'  
PK Nail in South Side 32" Walnut N. 60° W. 79.27'  
PK Nail in East Side 10" Box Elder N. 14° E. 41.44'

Signed by *Robert E. Snell*

Date 5-7-96

Surveyor's Michigan License No. 9734