

SURVEY & REMONUMENTATION

MAY 16 1996

COMMISSION

LAND CORNER RECORDATION CERTIFICATE
Filing Requirement of Act 74, Mich. P.A. 1970

STATE OF MICHIGAN
COUNTY OF KALAMAZOO
RECEIVED FOR RECORD

'96 APR 22 PM 4 23

James J. [Signature]
CLERK-REGISTER

LIBER 1 PAGE 1472

Register of Deeds Stamp & File Number


For corners in Kalamazoo (County)
Climax Twp.

Located In: Corner Code #

1. Public Land Survey	T <u>3</u> S. R <u>9</u> W.	<u>G-11</u>
	T ___ R ___	_____
	T ___ R ___	_____
	T ___ R ___	_____
2. Property Controlling in Section	S ___ T ___ R ___	_____
	S ___ T ___ R ___	_____
3. Miscellaneous Property in Section	S ___ T ___ R ___	_____
	S ___ T ___ R ___	_____

4. Lot No. _____, Recorded Plat _____

5. Private Claims _____

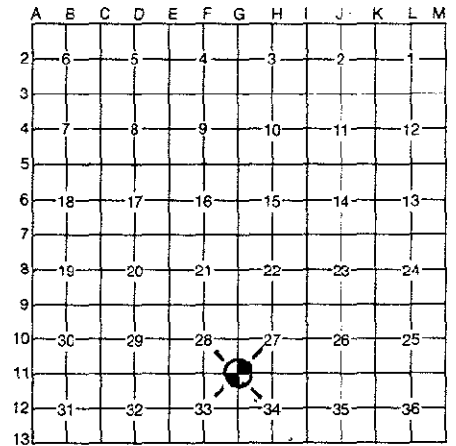

I, Robert E. Snell, in a field survey on February 21, 19 96, do hereby certify that under requirements of P.A. 74, Michigan P.A. of 1970, the corner points mentioned in lines 1 and 2 above were in conformance with regulations and rules therefore as required in the current manual of survey instructions of the United States Department of the Interior, Bureau of Land Management or by a decree of a Court of Law and/or that the corner points mentioned in lines 3, 4 and 5 above were in conformance with the rules of the Michigan Board of Professional Surveyors or by a Decree of a Court of Law; established, re-established, monumented, re-monumented, recovered, found as expressed below:

NOTE: Not more than 4 corners, all in the same town and range, may be recorded on this certificate.

A. Description of original monument and accessories and/or subsequent restoration:

- 1826: United States Government Surveyors; set post corner to Sections 27, 28, 33 and 34.
Elm 12" N. 25° W. 14½ lks.
Wh. Ash 14" S. 20° E. 14 lks.
- 1883: F. Hodgman; found a large granite boulder containing about 1 cubic yard lying on the surface of the earth in swamp and hole drilled in it for corner by R. Nutting. Measurements from the two U.S. bearing trees now dead and partly rotted away show the corner to be correct.

B. Description of corner evidence found and/or method applied in restoring or reestablishing corner:

- 1996: Found large boulder (3' x 3' x 3') as called for by F. Hodgman. Drill hole in top ½" x 2", Railroad rail fence post painted white with ½" pipe to South N. 76° E., 22.65 feet from corner.

RATIFIED
BY KALAMAZOO COUNTY
REMONUMENTATION
PEER GROUP
3/21/96 *[Signature]*

C. Description of monument for corner and accessories established to perpetuate locating the position of the corner:

- G-11: Southwest corner Section 27, T. 3 S., R. 9 W., Ratified by the Kalamazoo County Remonumentation Program Peer Group on March 21, 1996, and is accepted as a careful and faithful perpetuation of the position of the original corner. Found boulder as described by F. Hodgman in 1883 Remonumentation survey. Boulder with hole is retained as monument.
- | | | | |
|---------------------------|-----------|-----------|--------|
| PK Nail in South Side | 12" Maple | S. 17° W. | 17.40' |
| PK Nail in North Side | 23" Maple | S. 80° W. | 26.48' |
| PK Nail in West Side | 24" Maple | N. 18° W. | 37.45' |
| PK Nail in Southeast Side | 19" Maple | N. 40° E. | 18.92' |

Signed by *Robert E. Snell* Date 4-22-96
Surveyor's Michigan License No. 9734