

SURVEY & REMONUMENTATION

NOV 25 1998


LAND CORNER RECORDATION CERTIFICATE LIBER
Filing Requirement of Act 74, Mich. P.A. 1970

2 PAGE 340

SECTION

<u>KALAMAZOO</u> (County)	Located In:	Corner Code #
1. Public Land Survey	T <u>3S</u> R <u>9W</u>	<u>L-7</u>
	T _____ R _____	_____
	T _____ R _____	_____
	T _____ R _____	_____
2. Property Controlling in Section	S _____ T _____ R _____	_____
	S _____ T _____ R _____	_____
3. Miscellaneous Property in Sec.	S _____ T _____ R _____	_____
	S _____ T _____ R _____	_____
4. Lot No. _____, Recorded Plat		
5. Private Claims		

STATE OF MICHIGAN
COUNTY OF KALAMAZOO
RECEIVED FOR RECORD
'98 OCT 20 AM 11 25
Janet Johnson
Register of Deeds Stamp & File Number REGISTER

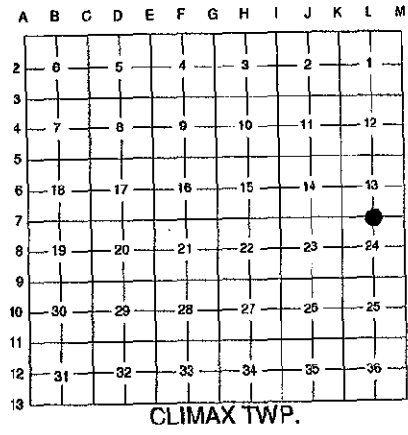

I, WILLIAM K. CRANE, P.S., in a field survey on OCTOBER, 19 97 do hereby state that under requirements of P.A. 74, Michigan P.A. of 1970, the corner points mentioned in lines 1 and 2 above were in conformance with regulations and rules therefore as required in the current manual of survey instructions of the United States Department of the Interior, Bureau of Land Management or by a decree of a Court of Law and /or that the corner points mentioned in lines 3, 4 and 5 above were in conformance with the rules of the Michigan Board of Land Surveyors or by a Decree of a Court of Law; established, re-established, monumented, recovered, found as expressed below:

NOTE: Not more than 2 corners, all in the same town and range, may be recorded on this certificate.

A. Description of original monument and accessories and/or subsequent restoration:

G.L.O., JUNE 1826, R. CLARK, Jr., D.S.:
9" BEECH, N10°E, 23 LINKS
9" BEECH, S.21°W, 8 LINKS

VOL 1:119 (RESURVEY)
"LOST. BIsected B, D AND FOUND THE STAKE. PLANTED NEW STAKE AND PUT A STONE 30" LONG OVER IT FROM WHICH SUGAR 30 S½°W 60 & SUGAR 36 S62°E 102."

VOL 2: 109 (RECORDS OF F. HODGEMAN, JULY, 1883)
"FOUND STONE OF RESURVEY WITH OLD STAKE HOLE UNDER IT. BORED DOWN 3'. FILLED THE BOTTOM WITH BROKEN BRICK AND PUT A 2' EARTHEN POST OVER IT WITH STONE AROUND AND MARKED."
8" MAPLE, N73½°E, 205 LINKS
8" W. ASH, S70°E, 173 ½ LINKS

RECORDS OF CRANE LAND SURVEYING, SEPT. 1988:
FOUND CLAY TILE, SET STEEL BAR
36" TRIPLE MAPLE, S60°W, 35.92'
30" OAK, S60°E, 42.36'
15" MAPLE, NORTH, 53.28'

RATIFIED
BY KALAMAZOO COUNTY
REMONUMENTATION
PEER GROUP
3-19-1998
W.K.C.

B. Description of corner evidence found and/or method applied in restoring or reestablishing corner:

FOUND CAPPED IRON NO. 29243, 1.5 FEET SOUTH OF THE CENTERLINE OF NORTH AND SOUTH ROAD. REMOVED IRON AND DUG APPROXIMATELY 2' AND FOUND CLAY TILE WITH "X" ON TOP. PLACE CAST SLEEVE OVER TILE AND INSTALLED A MONMENT BOX.


C. Description of monument for corner and accessories established to perpetuate locating the position of the corner:

FOUND CLAY TILE ACCEPTED AS A CAREFUL AND FAITHFUL PERPETUATION OF THE POSITION OF THE ORIGINAL CORNER. PLACED TILE SLEEVE AND MONUMENT BOX ON CORNER.

FOUND NAIL IN N. SIDE OF 30" OAK STUMP, S.52°E, 42.36'
FOUND NAIL IN S. SIDE OF 14" TWIN ASH, S.68°E, 67.38'
SET 16d NAIL IN E. SIDE OF 6" OAK, N.04°W, 34.87'
FOUND NAIL IN N. SIDE OF 14" TRIPLE ASH, S.68°W, 45.89'
1.5' SOUTH OF CENTERLINE OF EAST-WEST ROAD

Signed by *William K. Crane*
William K. Crane, P.S.

Date 10/19/98

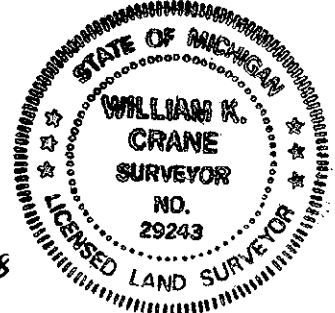

Surveyor's Michigan License No.: 29243