

NOV 25 1998

LIBER

2 PAGE 339

LAND CORNER RECORDATION CERTIFICATE  
Filing Requirement of Act 74, Mich. P.A. 1970

SECTION

KALAMAZOO

(County)

Located In:

Corner Code #

1. Public Land Survey

T 3S R 9W

M-7

T R

T R

T R

2. Property Controlling in Section

S T R

S T R

3. Miscellaneous Property in Sec.

S T R

S T R

4. Lot No. \_\_\_\_\_, Recorded Plat

5. Private Claims

I, WILLIAM K. CRANE, P.S., in a field survey on OCTOBER, 19 97 do hereby state that under requirements of P.A. 74, Michigan P.A. of 1970, the corner points mentioned in lines 1 and 2 above were in conformance with regulations and rules therefore as required in the current manual of survey instructions of the United States Department of the Interior, Bureau of Land Management or by a decree of a Court of Law and /or that the corner points mentioned in lines 3, 4 and 5 above were in conformance with the rules of the Michigan Board of Land Surveyors or by a Decree of a Court of Law; established, re-established, monumented, recovered, found as expressed below:

NOTE: Not more than 2 corners, all in the same town and range, may be recorded on this certificate.

A. Description of original monument and accessories and/or subsequent restoration:

G.L.O., NOV. 1825, J. MULLET, D.S.:

6" BEECH, N24°W, 18 LINKS  
9" BEECH, S.15°W, 28 LINKS

VOL 1:119 (RESURVEY)

"FOUND THE STAKE FORM THE STUMP OF ONE WITNESS & CORNER OF 18 & 19, LEROY. PLANTED STONE 18" LONE, 6"x6" ON TOP. NO TREES NEAR.

VOL 2: 109 (RECORDS OF F. HODGEMAN)

"FOUND CORNER STONE 6"x6"x24" OF RESURVEY, PUT A 1' EARTHEN POST UNDERNEATH AND REPLACED STONE WITH THE TOP EVEN WITH THE SURFACE".

B. Description of corner evidence found and/or method applied in restoring or reestablishing corner:

FOUND CLAY TILE WITH "X" ON TOP APPROXIMATELY 2 FEET BELOW GRAVEL ROAD SURFACE. PLACE A CAST TILE SLEEVE OVER TILE AND INSTALLED A MONUMENT BOX.

C. Description of monument for corner and accessories established to perpetuate locating the position of the corner:

FOUND CLAY TILE ACCEPTED AS A CAREFUL AND FAITHFUL PERPETUATION OF THE POSITION OF THE ORIGINAL CORNER. PLACED TILE SLEEVE AND MONUMENT BOX ON CORNER.

SET NAIL IN S. SIDE OF 8" MAPLE; N.79°W, 90.18'  
SET NAIL IN NW. SIDE OF 24" MAPLE; S.53°W, 54.07'  
SET NAIL IN N. SIDE OF 16" HICKORY; S.82°30'E, 243.11'  
NORTHWEST CORNER OF SEC. 19, T3S, R8W, LEROY TWP; SOUTH 14.92 FEET.  
7.5' NORTH OF CENTERLINE OF EAST-WEST ROAD

Signed by William K Crane


William K. Crane, P.S.

Date 10/19/98

Surveyor's Michigan License No.: 29243

STATE OF MICHIGAN  
COUNTY OF KALAMAZOO  
RECEIVED FOR RECORD  
'98 OCT 20 AM 11 25  
*Samuel Johnson*  
CLERK - REGISTER

Register of Deeds Stamp & File Number

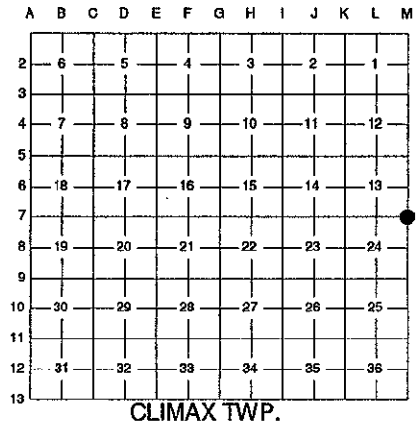

RATIFIED  
BY KALAMAZOO COUNTY  
REMONUMENTATION  
PEER GROUP  
3-19-1998  
*R. H. C.*

