



LC-000030

Page: 1 of 1

10/28/1999 03:11P  
Bk-2 Pg-483

**LAND CORNER RECORDATION CERTIFICATE**  
**Filing Requirement of Act 74, Mich. P.A. 1970**

For corners in

<u>Kalamazoo</u>	Located in:	Corner Code#
(County)		
Pavilion Township		
1. Public Land Survey	T <u>3S</u> R <u>10W</u>	<u>A-7</u>
	T _____ R _____	_____
	T _____ R _____	_____
	T _____ R _____	_____
2. Property Controlling in Section	S _____ T _____ R _____	_____
	S _____ T _____ R _____	_____
3. Miscellaneous Property in Sec.	S _____ T _____ R _____	_____
	S _____ T _____ R _____	_____
4. Lot No. _____, Recorded Plat _____		
5. Private Claims _____		

**SURVEY & REMONUMENTATION**

**FEB 08 2000**

**SECTION**

**Register of Deeds Stamp & File Number**

A	B	C	D	E	F	G	H	I	J	K	L	M
1												
2	6		5		4		3		2		1	
3												
4	7		8		9		10		11		12	
5												
6	18		17		16		15		14		13	
7												
8	19		20		21		22		23		24	
9												
10	30		29		28		27		26		25	
11												
12	31		32		33		34		35		36	
13												

I, Gary D. Hahn, in a field survey on January 22, 1999 do hereby state that under requirements of P.A. 74, Michigan P.A. of 1970, the corner points mentioned in lines 1 and 2 above were in conformance with regulations and rules therefore as required in the current manual of survey instructions of the United States Department of the Interior, Bureau of Land Management or by a decree of a Court of Law and /or that the corner points mentioned in lines 3, 4 and 5 above were in conformance with the rules of the Michigan Board of Land Surveyors or by a Decree of a Court of Law; established, re-established, monumented, recovered, found as expressed below:

**NOTE: Not more than 2 corners, all in the same town and range, may be recorded on this certificate.**

**A. Description of original monument and accessories and/or subsequent restoration:**

1827 - Corner established by U.S. Deputy Surveyor Robert Clark, Jr.  
"Int. W. Line 79L. S. of post. Set post at inter. cor. secs. 18 + 19".  
W. Oak 14 N. 51°E. 85L  
W. Oak S. 8½°E. 74 lks.

1870 - F. Hodgeman: "Stake set by Smith from which Hick. 10 S. 36°W. 59 Hick. 10 S. 30½°E. 88"

1888 - F. Hodgeman: "Found stone with drill hole set on former survey. Set post with stone beside. This is ? the fence in field south side of road".

1951 - Wilkins & Wheaton Engineering: Found tile.

1979 - Wilkins & Wheaton Engineering: Stone 12" Elm S. 45°E. 46.8 feet Manhole N. 20.8 feet Power pole N 10°E. 58.0 feet.

**B. Description of corner evidence found and/or method applied in restoring or reestablishing corner:**

Original monument and accessories not recovered.  
1999 - Found tile standing just northeast of a large stone. Tile is in line and under a chain link fence running to the south.


**C. Description of monument for corner and accessories established to perpetuate locating the position of the corner:**

A-7, Southwest Corner Section 18, Town 3 South, Range 10 West. Ratified by the Kalamazoo County Remonumentation Peer Group on May 20, 1999. Position of the tile is accepted as a careful and faithful perpetuation of the position of the original closing corner. Set a remonumentation sleeve over tile.

**Witness Ties:**

Center of sanitary manhole N. 21.00 feet  
Set P.K. nail in 20" Cedar S. 5°E. 19.29 feet  
Found pointed stone (Portage corner) N. 51.61 feet  
Set P.K. nail in 7" Hickory N. 65°W. 19.59 feet  
Set P.K. nail in power pole S. 35°W. 40.88 feet

**RATIFIED**  
**BY KALAMAZOO COUNTY**  
**REMONUMENTATION**  
**PEER GROUP**  
5-20-1999 *R. E. G.*

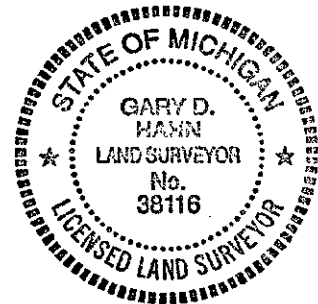

Signed by *Gary D. Hahn*  
Surveyor's Michigan License No. 38116

Date 07/22/99

FORM APPROVED BY MICHIGAN STATE BOARD OF PROFESSIONAL SURVEYORS,  
JAN. 28, 1971

REVISED MAY 14, 1975  
REVISED JAN., 1983 REVISED OCT., 1995