

SURVEY & REMONUMENTATION

FEB 26 1998

7-
SECTION

LAND CORNER RECORDATION CERTIFICATE
Filing Requirement of Act 74, Mich. P.A. 1970

For corners in Pavilion Twp.


Kalamazoo (County)	Located In:	Corner Code #
1. Public Land Survey	T 3S R 10W	B-01
	T R	
	T R	
	T R	
	T R	
2. Property Controlling in Section	S T R	
	S T R	
3. Miscellaneous Property in Sec.	S T R	
	S T R	

LIBER
CLERK - REGISTER
2 PAGE 278
97 DEC 29 AM 10 56
STATE OF MICHIGAN
COUNTY OF KALAMAZOO
RECEIVED FOR RECORD

Register of Deeds Stamp & File Number

4. Lot No. _____, Recorded Plat _____
5. Private Claims _____

I, Robert E. Snell, in a field survey on Sept. 23 19 97 do hereby state that under requirements of P.A. 74, Michigan P.A. of 1970, the corner points mentioned in lines 1 and 2 above were in conformance with regulations and rules therefore as required in the current manual of survey instructions of the United States Department of the Interior, Bureau of Land Management or by a decree of a Court of Law and for that the corner points mentioned in lines 3, 4 and 5 above were in conformance with the rules of the Michigan Board of Land Surveyors or by a Decree of a Court of Law; established, re-established, monumented, recovered, found as expressed below:

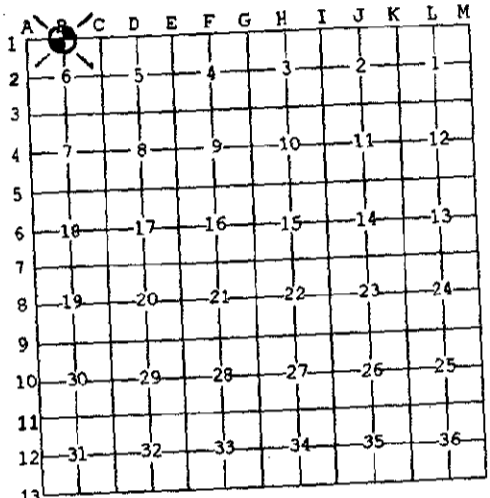

NOTE: Not more than 2 corners, all in the same town and range, may be recorded on this certificate.

A. Description of original monument and accessories and/or subsequent restoration:

This corner not set by original Government Surveyors.
1872: S. Hodgman, Deputy Land Surveyor; "Found corresponding corner for Township N (Comstock) set by some former surveyor, probably Streater ... measured E. 280 lks. and set stone with + for" (North 1/4 post, Section 6, Pavilion).

RATIFIED
BY KALAMAZOO COUNTY
REMONUMENTATION
PEER GROUP
12/18/97

B. Description of corner evidence found and/or method applied in restoring or reestablishing corner:

1964: Ingersoll, Watson, McMachen, Surveyors; North 1/4 post Section 6, Pavilion, sleeve and iron over stone with "x" on top.
34" Maple N. 08° W. 28.56' 30" Oak S. 01° W. 57.18'
Tele. Pole S. 60° W. 71.61'
1972: Gove & Associates, Surveyors; found 1/2" iron in 2 1/2" pipe.
1997: Found 1/2" x 16" iron in 2 1/2" pipe fitting over stone with "x" down 2 1/2' + below surface.

C. Description of monument for corner and accessories established to perpetuate locating the position of the corner:

B-01: North 1/4 post, Section 6, T. 3 S., R. 10 W., ratified by the Kalamazoo County Remonumentation Program Peer Group on December 18, 1997 and is accepted as a careful and faithful perpetuation of the position of the corner as set by S. Hodgman, Deputy Land Surveyor in 1872. Found 1/2" x 16" iron over stone with "x" on top. Set 20" Harrison Monument in place of stone in monument box.
60d Nail in West Side Large Power Pole S. 54° E. 68.18'
PK Nail in West Side (Abandoned) Power Pole S. 10° W. 70.40'
PK Nail in North Shoulder of Road N. 80° E. 85.01'
PK Nail in West Side 3" Box Elder N. 02° W. 35.03'

Signed by Robert E. Snell
Surveyor's Michigan License No. 9734

Date 12-23-97