

AUG 22 1995

LAND CORNER RECORDATION CERTIFICATE
Filing Requirement of Act 74, Mich. P.A. 1970

'95 MAR 23 PM 4 09

For corners in PAVILION TWP.
KALAMAZOO
(County)

Located In:

Corner Code #

- | | | |
|--------------------------------------|----------------------------|------------|
| 1. Public Land Survey | T <u>3</u> S R <u>10</u> W | <u>E-2</u> |
| | T _____ R _____ | _____ |
| | T _____ R _____ | _____ |
| | T _____ R _____ | _____ |
| 2. Property Controlling in Section | S _____ T _____ R _____ | _____ |
| | S _____ T _____ R _____ | _____ |
| 3. Miscellaneous Property in Section | S _____ T _____ R _____ | _____ |
| | S _____ T _____ R _____ | _____ |

LIBER

1 PG 1279

Register of Deeds Stamp & File Number

Janeal Jones
CLERK-REGISTER

4. Lot No. _____, Recorded Plat _____
5. Private Claims _____

	A	B	C	D	E	F	G	H	I	J	K	L	M
2	6			5	4			3		2			1
3													
4	7			8	9			10		11			12
5													
6	18			17	16			15		14			13
7													
8	19			20	21			22		23			24
9													
10	30			29	28			27		26			25
11													
12	31			32	33			34		35			36
13													

I, Allen H. McMachen field survey on January 11, 19 95, do hereby certify that under requirements of P.A. 74, Michigan P.A. of 1970, the corner points mentioned in lines 1 and 2 above were in conformance with regulations and rules therefore as required in the current manual of survey instructions of the United States Department of the Interior, Bureau of Land Management or by a decree of a Court of Law and/or that the corner points mentioned in lines 3, 4 and 5 above were in conformance with the rules of the Michigan Board of Professional Surveyors or by a Decree of a Court of Law; established, re-established, monumented, re-monumented, recovered, found as expressed below:

NOTE: Not more than 4 corners, all in the same town and range, may be recorded on this certificate.

A. Description of original monument and accessories and/or subsequent restoration:

1827 - R. Clark, D.S., Set Quarter Section Post
W. Oak 16" S. 35° W. 42 lks.
W. Oak 8" N. 31° W. 23 lks.


1888 - F. Hodgeman, C.S., Found Stone and Brick set for corner
N. 35° E. 42 lks. from stump of bearing tree, Set Post.
Hickory 10" S. 70° E. 127½ lks.

B. Description of corner evidence found and/or method applied in restoring or reestablishing corner:

Found Clay Tile 1.8' below surface.

RATIFIED
BY KALAMAZOO COUNTY
REMONUMENTATION
PEER GROUP

2/16/95

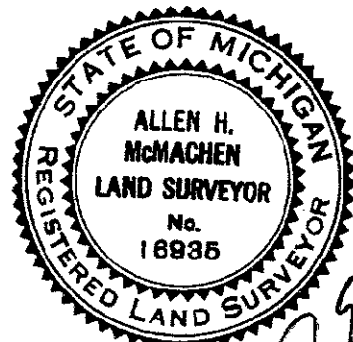

2.25

C. Description of monument for corner and accessories established to perpetuate locating the position of the corner:

Found Clay Tile is accepted as a careful and faithful perpetuation of the position of the original corner. Placed Harrison monument over existing Clay Tile and monument box over. Accessories:

- Nail & Tab in W. Face 6" Oak N. 05° E. 27.68'
- Nail & Tab in S.E. Face 8" Maple N. 55° E. 49.01'
- Nail & Tab in N.E. Face 8" Maple S. 55° E. 41.61'
- Nail & Tab in W. Face 18" Thornapple SOUTH 25.34'

Signed by Allen H. McMachen
Surveyor's Michigan License No. 16935

Date 3/22/95