

SURVEY & REMONUMENTATION

SEP 14 1998

1
2

SECTION

For corners in Pavilion Twp.

Kalamazoo
(County)

Located In:

Corner Code #

1. Public Land Survey

T	3S	R	10W	E-09
T		R		
T		R		
T		R		
S		T	R	
S		T	R	
S		T	R	
S		T	R	

2. Property Controlling in Section

3. Miscellaneous Property in Sec.

4. Lot No. _____, Recorded Plat _____

5. Private Claims _____

LIBER

2 PAGE 312

CLERK - REGISTER

Jessie Johnson

98 SEP 3 PM 3 25


RECEIVED FOR RECORD

STATE OF MICHIGAN

Register of Deeds Stamp & File Number

I, Robert E. Snell, in a field survey on May 1, 1998 do hereby state that under requirements of P.A. 74, Michigan P.A. of 1970, the corner points mentioned in lines 1 and 2 above were in conformance with regulations and rules therefore as required in the current manual of survey instructions of the United States Department of the Interior, Bureau of Land Management or by a decree of a Court of Law and/or that the corner points mentioned in lines 3, 4 and 5 above were in conformance with the rules of the Michigan Board of Land Surveyors or by a Decree of a Court of Law; established, re-established, monumented, recovered, found as expressed below:

NOTE: Not more than 2 corners, all in the same town and range, may be recorded on this certificate.

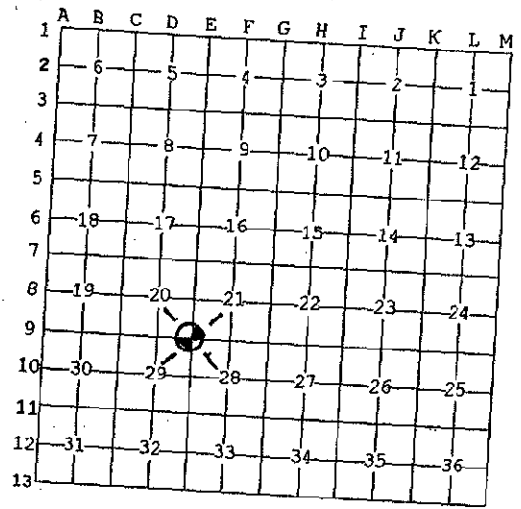

A. Description of original monument and accessories and/or subsequent restoration:

- 1826: United States Government Surveyors; set post, corner to Sections 20, 21, 28 and 29.
White Oak 24" S. 75¹/₂^o W. 900 lks.
White Oak 24" S. 05^o E. 177 lks.
- 1888: F. Hodgman, County Surveyor; "Stones of former survey (1885). Set post."
White Oak 10" S. 14^o W. 185 lks.
Red Oak 9" N. 09^o E. 215 lks.

B. Description of corner evidence found and/or method applied in restoring or reestablishing corner:

- 1998: Found iron of former surveyor with 3" round tile with "x" on top, 2 1/2 ft. below surface of road.

RATIFIED
BY KALAMAZOO COUNTY
REMONUMENTATION
PEER GROUP
5-21-1998

C. Description of monument for corner and accessories established to perpetuate locating the position of the corner:

- E-09: Southeast corner, Section 20, T. 3 S., R. 10 W., ratified on May 21, 1998 by the Kalamazoo County Remonumentation Program Peer Group and is accepted as a careful and faithful perpetuation of the position of the original corner. Found 1/2" x 18" iron over tile. Iron 0.06' East, 0.01' North of tile. Tile was set by F. Hodgman, County Surveyor in 1888 Remonumentation Survey. Placed 18" Harrison monument over tile in monument box.
- | | | | |
|---------------------------|-----------------------|-----------------------|--------|
| 1/2" x 18" Iron (Red Cap) | East Edge of Pavement | N. 45 ^o E. | 17.60' |
| PK Nail in West Side | 34" Wild Cherry | S. 24 ^o E. | 64.51' |
| 1/2" x 18" Iron (Red Cap) | West Edge of Pavement | S. 45 ^o W. | 16.11' |
| 1/2" x 18" Iron (Red Cap) | West Edge of Pavement | N. 45 ^o W. | 12.42' |

Signed by Robert E. Snell
Surveyor's Michigan License No. 9734

Date 9-2-98