SURVEY &
REMONUMENTATION

APR 27 1995

COMMISSION

LAND CORNER RECORDATION CERTIFICATE

Filing Requirement of Act 74, Mich. P.A. 1970

STATE OF MICHIGAN
COUNTY OF KALAMAZOO
RECEIVED FOR RECORD
'94 DEC 30 AM 9 18
CLERK-REGISTER

LIBER 1 PG 1243

Register of Deeds Stamp & File Number

For corners in
Kalamazoo (County)
Pavilion Township

	Located In:	Corner Code ##
1. Public Land Survey	T 3 S R 10 W	E-13
	T ___ R ___	
	T ___ R ___	
	T ___ R ___	
2. Property Controlling	S ___ T ___ R ___	
in Section	S ___ T ___ R ___	
3. Miscellaneous	S ___ T ___ R ___	
Property in Sec.	S ___ T ___ R ___	

4. Lot No. _____, Recorded Plat _____
5. Private Claims _____

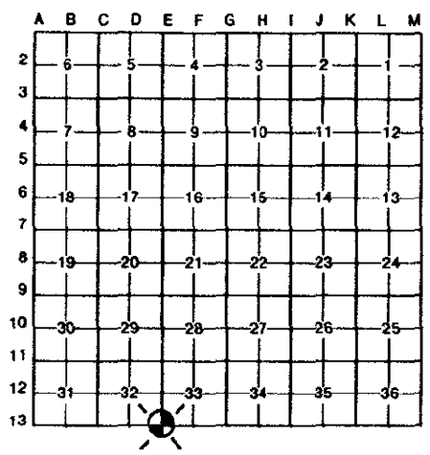

I, Robert E. Snell, in a field survey on June 2, 19 94, do hereby certify that under requirements of P.A. 74, Michigan P.A. of 1970, the corner points mentioned in lines 1 and 2 above were in conformance with regulations and rules therefore as required in the current manual of survey instructions of the United States Department of the Interior, Bureau of Land Management or by a decree of a Court of Law and/or that the corner points mentioned in lines 3, 4 and 5 above were in conformance with the rules of the Michigan Board of Land Surveyors or by a Decree of a Court of Law; established, re-established, monumented, re-monumented, recovered, found as expressed below:

NOTE: Not more than 4 corners, all in the same town and range, may be recorded on this certificate.

A. Description of original monument and accessories and/or subsequent restoration:

1825: U.S. Government Survey; Set Post Corner to Sections 32 and 33.

Wh. Oak	9"	North	76°	East	20 Lks
Wh. Oak	9"	North	86°	West	12 Lks

1888: F. Hodgman, County Surveyor; Found old stake packed around with stones. Set Post.

W. Oak	18"	South	45°	West	46 Lks
Hickory	8"	North	09°	West	47 Lks

B. Description of corner evidence found and/or method applied in restoring or reestablishing corner:

1994: Found PK nail in road, 1.0' South of Center Line and 33' North of broken plat monument. Three (3) feet below surface found 3" round tile about 0.4' South of position of PK nail.

NOTE: This Corner is a corner in common with Northwest Corner Section 4 (E-1) Brady Township.

RATIFIED
BY KALAMAZOO COUNTY
REMONUMENTATION
PEER GROUP
7-21-94

C. Description of monument for corner and accessories established to perpetuate locating the position of the corner:

E-13 Southeast Corner of Section 32, T. 3 S., R. 10 W., Ratified by the Kalamazoo County Remonumentation Program Peer Group on July 21, 1994. Found 3" round tile as placed in 1888 remonumentation survey by F. Hodgman and is accepted as a careful and faithful perpetuation of the position of the original corner. Placed a 20" Harrison monument with monument box over.

PK Nail in West Side	Power Pole	North 18° East 33.07'
Northwest Corner of Top Brick on	15" Sq. W. Drive Piller	North 52° East 72.26'
PK Nail in Northeast Side	12" Poplar	South 50° East 45.34'
PK Nail in East Side	20" Poplar	South 24° West 44.76'
Center Line "T" Avenue		North 1.00'

Signed by Robert E. Snell Date 12/28/94

Surveyor's Michigan License No. 9734

FORM APPROVED BY MICHIGAN STATE BOARD OF LAND SURVEYORS, JAN. 28, 1971
REVISED MAY 14, 1975
REVISED JAN., 1983