

SURVEY & REMONUMENTATION

MAY 16 1996
COMMISSION

LAND CORNER RECORDATION CERTIFICATE
Filing Requirement of Act 74, Mich. P.A. 1970

STATE OF MICHIGAN
COUNTY OF KALAMAZOO
RECEIVED FOR RECORD
'96 APR 22 PM 4 23

For corners in Kalamazoo Located In: _____ Corner Code # _____
(County)
Pavilion Twp.

1. Public Land Survey	T <u>3</u> S. R <u>10</u> W.	<u>F-05</u>
	T _____ R _____	_____
	T _____ R _____	_____
	T _____ R _____	_____
2. Property Controlling in Section	S _____ T _____ R _____	_____
	S _____ T _____ R _____	_____
3. Miscellaneous Property in Section	S _____ T _____ R _____	_____
	S _____ T _____ R _____	_____


4. Lot No. _____, Recorded Plat _____
5. Private Claims _____

James D. Young
CLERK-REGISTER

LIBER 1 PAGE 1476

Register of Deeds Stamp & File Number

I, Robert E. Snell, in a field survey on February 22, 1996, do hereby certify that under requirements of P.A. 74, Michigan P.A. of 1970, the corner points mentioned in lines 1 and 2 above were in conformance with regulations and rules therefore as required in the current manual of survey instructions of the United States Department of the Interior, Bureau of Land Management or by a decree of a Court of Law and/or that the corner points mentioned in lines 3, 4 and 5 above were in conformance with the rules of the Michigan Board of Professional Surveyors or by a Decree of a Court of Law; established, re-established, monumented, re-monumented, recovered, found as expressed below:

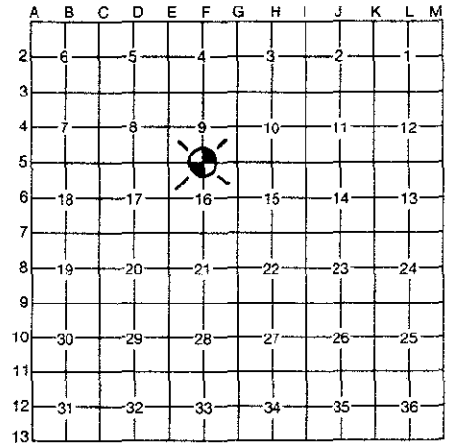

NOTE: Not more than 4 corners, all in the same town and range, may be recorded on this certificate.

A. Description of original monument and accessories and/or subsequent restoration:

- 1827: United States Government Surveyors; set 1/4 Section post.
 Tam. 7" N. 08° E. 37 lks.
 Y. Oak 14" S. 70° W. 97 lks.
- 1888: F. Hodgman, County Surveyor; found stake and stones and bearing trees of re-survey all in place. Set post.

B. Description of corner evidence found and/or method applied in restoring or reestablishing corner:

- 1986: Acro Engineering Co.; found tile in monument box.
 Power Pole N. 80° W. 48.10'
 Maple East 78.30'
 24" Oak N. 80° W. 156.70'
 Utility Pole N. 30° E. 74.00'
 In traveled center line of Road
- 1996: Found 3" round tile in monument box.

RATIFIED
BY KALAMAZOO COUNTY
REMONUMENTATION
PEER GROUP
3/21/96 *[Signature]*

C. Description of monument for corner and accessories established to perpetuate locating the position of the corner:

- F-05: South 1/4 post Section 9, T. 3 S., R. 10 W., Ratified by the Kalamazoo County Remonumentation Program Peer Group on March 21, 1996, and is accepted as a careful and faithful perpetuation of the position of the original corner. Found 3" round tile in monument box, tile set in 1888 by F. Hodgman in a Remonumentation survey. Placed remonumentation sleeve over tile in monument box.
- | | | | |
|-------------------------------|----------------|-----------|--------|
| PK Nail in North Side | 9" Maple | N. 64° E. | 38.70' |
| PK Nail in North Side | 6" Maple | S. 32° E. | 48.50' |
| PK Nail in North Side | 8" Pine | S. 76° W. | 54.25' |
| Exist. Nail/Tab in North Side | Telephone Pole | N. 66° W. | 48.82' |

Signed by *Robert E. Snell* Date 4-19-96
 Surveyor's Michigan License No. 9734