

LAND CORNER RECORDATION CERTIFICATE
Filing Requirement of Act 74, Mich. P.A. 1970

For corners in

Kalamazoo
 (County)
 Pavilion Twp.
 1. Public Land Survey
 Located In: T 3S R 10W
 Corner Code# F6

2. Property Controlling in Section
 3. Miscellaneous Property in Sec.

S _____ T _____ R _____
 S _____ T _____ R _____
 S _____ T _____ R _____
 S _____ T _____ R _____

SURVEY & REMONUMENTATION

FEB 08 2000

SECTION

Register of Deeds Stamp & File Number

4. Lot No. _____, Recorded Plat _____
 5. Private Claims _____

I, Gary D. Hahn, in a field survey on July 30, 1999
 do hereby state that under requirements of P.A. 74, Michigan P.A. of 1970, the corner points mentioned in lines 1 and 2 above were in conformance with regulations and rules therefore as required in the current manual of survey instructions of the United States Department of the Interior, Bureau of Land Management or by a decree of a Court of Law and /or that the corner points mentioned in lines 3, 4 and 5 above were in conformance with the rules of the Michigan Board of Land Surveyors or by a Decree of a Court of Law; established, re-established, monumented, recovered, found as expressed below:

	A	B	C	D	E	F	G	H	I	J	K	L	M
1													
2	6		5		4		3		2		1		
3													
4	7		8		9		10		11		12		
5													
6	16		17		18		15		14		13		
7													
8	19		20		21		22		23		24		
9													
10	30		29		28		27		26		25		
11													
12	31		32		33		34		35		36		
13													

NOTE: Not more than 2 corners, all in the same town and range, may be recorded on this certificate.

A. Description of original monument and accessories and/or subsequent restoration:

This corner not established by the G.L.O. Survey.

1874 - F. Hodgman: "At intersection of quarter lines set stone and marked Wh. Oak 10 S 78° 05' E 158 W. Oak 40 N 10 ° 40' W 146"

1885 - F. Hodgman: "Corner set on former survey"

KCRC Witness Ties: 30" Wh. Oak N 15 ° W 60.17 feet
 P.P. S 35 ° W 61.42 feet
 Power Pole S 65 ° E 53.29 feet

B. Description of corner evidence found and/or method applied in restoring or reestablishing corner:


Found a 1" diameter 12" long rod in a monument box. Removed rod and found a 6" x 8" x 10" pointed stone with an "X" on the point. Stone is 23" below road surface. Stone is directly below surface marker.

C. Description of monument for corner and accessories established to perpetuate locating the position of the corner:

F6, Center of Section 16, Town 3 South, Range 10 West. Ratified by the Kalamazoo County Remonumentation Peer Group on August 19, 1999. This position not established by original Government Surveyors. This monument is accepted as the best available evidence of the corner. Set an 18" long Harrison monument in a monument box directly over the "X" on the stone.

Witness Ties: Set Mag nail in 20" Maple N 39 ° E 50.58 feet
 Set Mag nail in 12" Maple S 57 ° E 41.04 feet
 Set Mag nail in power pole S 70 ° W 75.38 feet
 Set Mag nail in 26" Maple N 35 ° W 60.28 feet

RATIFIED
BY KALAMAZOO COUNTY
REMONUMENTATION
PEER GROUP
 8-19-1999

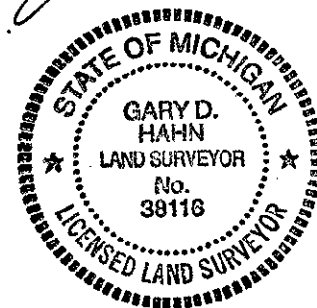

Signed by [Signature]
 Surveyor's Michigan License No. 38116

Date 10/18/99