

SURVEY & REMONUMENTATION

FEB 18 1994

COMMISSION

LIBER 1 PG 1084

LAND CORNER RECORDATION CERTIFICATE
Filing Requirement of Act 74, Mich. P.A. 1970


For corners in PAVILION TWP.

KALAMAZOO <small>(County)</small>	Located In:	Corner Code #
1. Public Land Survey	T <u>3S</u> R <u>10W</u>	<u>G-3</u>
	T _____ R _____	_____
	T _____ R _____	_____
	T _____ R _____	_____
2. Property Controlling in Section	S _____ T _____ R _____	_____
	S _____ T _____ R _____	_____
3. Miscellaneous Property in Sec.	S _____ T _____ R _____	_____
	S _____ T _____ R _____	_____

STATE OF MICHIGAN
COUNTY OF KALAMAZOO
RECEIVED FOR RECORD
94 JUN 20 PM 3 09
J. J. J. J.
CLERK - REGISTER

Register of Deeds Stamp & File Number

4. Lot No. _____, Recorded Plat _____
5. Private Claims _____

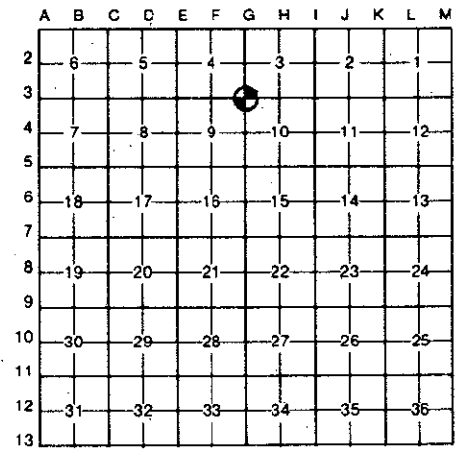

I, Allen H. McMachen a field survey on December 4, 19 93, do hereby certify that under requirements of P.A. 74, Michigan P.A. of 1970, the corner points mentioned in lines 1 and 2 above were in conformance with regulations and rules therefore as required in the current manual of survey instructions of the United States Department of the Interior, Bureau of Land Management or by a decree of a Court of Law and/or that the corner points mentioned in lines 3, 4 and 5 above were in conformance with the rules of the Michigan Board of Land Surveyors or by a Decree of a Court of Law; established, re-established, monumented, re-monumented, recovered, found as expressed below:

NOTE: Not more than 4 corners, all in the same town and range, may be recorded on this certificate.

A. Description of original monument and accessories, and/or subsequent restoration:

1888 - F. Hodgeman C.S. placed Clay Tile post during official Township Remonumentation.

B. Description of corner evidence found and/or method applied in restoring or reestablishing corner:

Found Clay Tile 4" above ground with ring of stones.

RATIFIED
BY KALAMAZOO COUNTY
REMONUMENTATION
PEER GROUP
12-16-93



C. Description of monument for corner and accessories established to perpetuate locating the position of the corner:

Found Clay Tile is accepted as a careful and faithful perpetuation of the original corner. Placed Standard Sleeve over existing Tile; accessories:

Nail in South face	16"	Oak	S. 85 deg. E. 41.19'
Nail in South face	30"	Oak	S. 14 deg. E. 17.40'
Nail in East face	10"	Sassafras	S. 10 deg. W. 4.89'
Nail in North face	24"	Oak	WEST 31.32'

Signed by Allen H. McMachen
Surveyor's Michigan License No. 16935

Date 1/20/94