

**SURVEY & REMONUMENTATION**

AUG 06 1996

COMMISSION

**LAND CORNER RECORDATION CERTIFICATE**  
**Filing Requirement of Act 74, Mich. P.A. 1970**

For corners in Kalamazoo  
(County)  
Pavilion Twp.

Located In:

Corner Code #


1. Public Land Survey	T <u>3</u> S.	R <u>10</u> W.	<u>G-09</u>
	T _____	R _____	_____
	T _____	R _____	_____
	T _____	R _____	_____
2. Property Controlling in Section	S _____	T _____	R _____
	S _____	T _____	R _____
3. Miscellaneous Property in Section	S _____	T _____	R _____
	S _____	T _____	R _____

STATE OF MICHIGAN  
 COUNTY OF KALAMAZOO  
 RECEIVED FOR RECORD  
 '96 MAY 23 PM 1 47  
*James J. [Signature]*  
 CLERK - REGISTER

LIBER **1** PAGE **1498**  
 Register of Deeds Stamp & File Number

4. Lot No. \_\_\_\_\_, Recorded Plat \_\_\_\_\_  
 5. Private Claims \_\_\_\_\_

I, Robert E. Snell, in a field survey on February 22, 19 96, do hereby certify that under requirements of P.A. 74, Michigan P.A. of 1970, the corner points mentioned in lines 1 and 2 above were in conformance with regulations and rules therefore as required in the current manual of survey instructions of the United States Department of the Interior, Bureau of Land Management or by a decree of a Court of Law and/or that the corner points mentioned in lines 3, 4 and 5 above were in conformance with the rules of the Michigan Board of Professional Surveyors or by a Decree of a Court of Law; established, re-established, monumented, re-monumented, recovered, found as expressed below:

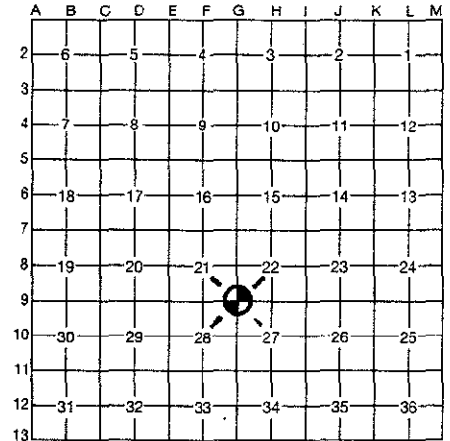

**NOTE: Not more than 4 corners, all in the same town and range, may be recorded on this certificate.**

**A. Description of original monument and accessories and/or subsequent restoration:**

- 1827: United States Government Surveyors; set post, corner to Sections 21, 22, 27 and 28.  
 Beech 11" N. 21° E. 10 lks.  
 Wh. Ash 15" S. 28° E. 27 lks.
- 1887: F. Hodgman, County Surveyor; found stake standing N. 28° W. 27 lks. from W. Ash bearing tree. Beech bearing tree N. 21° E. 10 lks. fallen. Set post.  
 Butternut 3" N. 75°± E. 15 lks.

**B. Description of corner evidence found and/or method applied in restoring or reestablishing corner:**

1995: Found tile in monument box.

**RATIFIED**  
**BY KALAMAZOO COUNTY**  
**REMONUMENTATION**  
**PEER GROUP**  
 3-21-1996 *R.E.S.*

**C. Description of monument for corner and accessories established to perpetuate locating the position of the corner:**

G-09: Southeast corner Section 21, T. 3 S., R. 10 W., Ratified by the Kalamazoo County Remonumentation Program Peer Group on March 21, 1996 and is accepted as a careful and faithful perpetuation of the position of the original corner. Found 3" round tile as set by F. Hodgman, County Surveyor in a 1887 remonumentation survey, in a monument box. Set remonumentation sleeve over tile in monument box.

PK Nail in North Side	20" Maple	S. 38° W.	49.85'
PK Nail in West Side	4" Maple	S. 02° W.	37.20'
PK Nail in Northwest Side	34" Oak	S. 48° W.	44.59'
PK Nail in Southwest Side	Power Pole	N. 30° W.	49.63'

Signed by *Robert E. Snell*

Date 5-23-96

Surveyor's Michigan License No. 9734