

SURVEY &
REMONUMENTATION

OCT 06 1997

COMMISSION

LAND CORNER RECORDATION CERTIFICATE
Filing Requirement of Act 74, Mich. P.A. 1970


For corners in Pavilion Twp.

<u>Kalamazoo</u> (County)	Located In:	Corner Code #
1. Public Land Survey	T <u>3S</u> R <u>10W</u>	<u>H-04</u>
	T ___ R ___	_____
	T ___ R ___	_____
	T ___ R ___	_____
2. Property Controlling in Section	S ___ T ___ R ___	_____
	S ___ T ___ R ___	_____
3. Miscellaneous Property in Sec.	S ___ T ___ R ___	_____
	S ___ T ___ R ___	_____

STATE OF MICHIGAN
COUNTY OF KALAMAZOO
RECEIVED FOR RECORD
1997 JUL 29 AM 11 01
CLERK - REGISTER
Annally Johnson
LIBER 2PAGE 165
Register of Deeds Stamp & File Number

4. Lot No. _____, Recorded Plat _____
5. Private Claims _____

I, Robert E. Snell, in a field survey on May 29, 1997 do hereby state that under requirements of P.A. 74, Michigan P.A. of 1970, the corner points mentioned in lines 1 and 2 above were in conformance with regulations and rules therefore as required in the current manual of survey instructions of the United States Department of the Interior, Bureau of Land Management or by a decree of a Court of Law and /or that the corner points mentioned in lines 3, 4 and 5 above were in conformance with the rules of the Michigan Board of Land Surveyors or by a Decree of a Court of Law, established, re-established, monumented, recovered, found as expressed below:

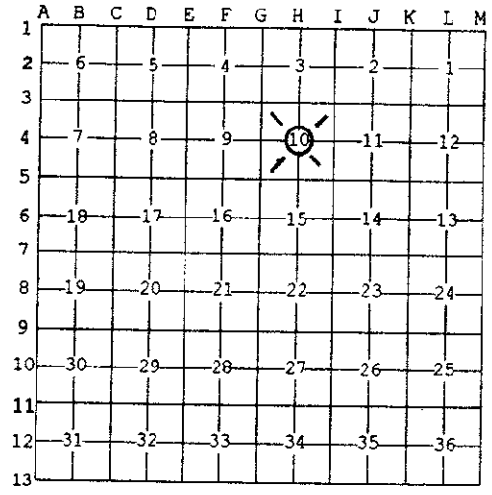

NOTE: Not more than 2 corners, all in the same town and range, may be recorded on this certificate.

A. Description of original monument and accessories and/or subsequent restoration:
This corner not set by original Government Surveyors.

RES
RATIFIED
BY KALAMAZOO COUNTY
REMONUMENTATION
PEER GROUP
4-17-1997

B. Description of corner evidence found and/or method applied in restoring or reestablishing corner:
1977: Al McMachen, RLS #16935; L.C.R.C., L-1, P-735, found 3/4" iron.
6" W. Cherry S. 40° E. 22.84'
15" W. Cherry North 11.60'
2' West of North & South fence line.
1996: Wilkins & Wheaton Engineering Co.; Determined by survey 3/4" iron was 0.05' South and 2.01' East of true intersection.
1997: Wightman/Ward: Contracted by Kalamazoo County Remonumentation Program Peer Group to re-run Section lines to verify center 1/4 post. It was determined by Peer Group to accept location of 3/4" iron rod.

C. Description of monument for corner and accessories established to perpetuate locating the position of the corner:
H-04: Center 1/4 post, Section 10, T. 3 S., R. 10 W., ratified by the Kalamazoo County Remonumentation Program Peer Group on April 17, 1997, as the best available evidence as to the true location of the corner. This corner not established by original Government Surveyors. Found 3/4" iron rod 3' long and replaced with 30" Harrison monument.
Tree line to North East 3.2'
Tree line to West South 2.5'
PK Nail in North Side Fence Post S. 85° E. 38.85'
PK Nail in North Side 18" Twin W. Cherry S. 25° E. 22.55'
PK Nail in South Side 14" Oak N. 80° W. 17.05'

Signed by *Robert E. Snell* Date 7-28-97
Surveyor's Michigan License No. 9734