

APR 01 1996

COMMISSION

LAND CORNER RECORDATION CERTIFICATE
Filing Requirement of Act 74, Mich. P.A. 1970

STATE OF MICHIGAN
COUNTY OF KALAMAZOO
RECEIVED FOR RECORD

'95 NOV 9 AM 8 48


James J. Jones
CLERK-REGISTER

For corners in

<u>Kalamazoo</u> (County)	Located In:	Corner Code #
<u>Pavilion Twp.</u>		
1. Public Land Survey	T <u>3</u> S R <u>10</u> W	<u>1-6</u>
	T _____ R _____	_____
	T _____ R _____	_____
	T _____ R _____	_____
2. Property Controlling in Section	S _____ T _____ R _____	_____
	S _____ T _____ R _____	_____
3. Miscellaneous Property in Sec.	S _____ T _____ R _____	_____
	S _____ T _____ R _____	_____
4. Lot No. _____, Recorded Plat _____		
5. Private Claims _____		

LIBER **1 1368**
Register of Deeds Stamp & File Number

I, Robert E. Snell, in a field survey on August 24, 19 95, do hereby certify that under requirements of P.A. 74, Michigan P.A. of 1970, the corner points mentioned in lines 1 and 2 above were in conformance with regulations and rules therefore as required in the current manual of survey instructions of the United States Department of the Interior, Bureau of Land Management or by a decree of a Court of Law and/or that the corner points mentioned in lines 3, 4 and 5 above were in conformance with the rules of the Michigan Board of Land Surveyors or by a Decree of a Court of Law; established, re-established, monumented, re-monumented, recovered, found as expressed below:

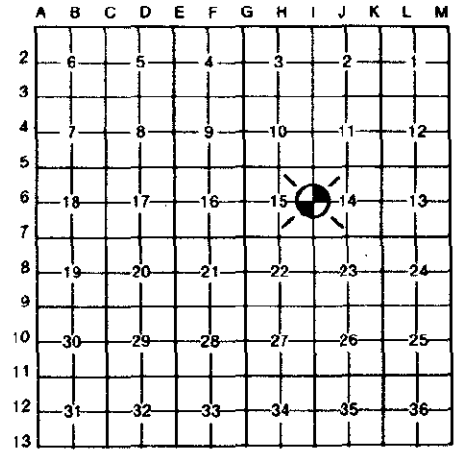

NOTE: Not more than 4 corners, all in the same town and range, may be recorded on this certificate.

- A. Description of original monument and accessories and/or subsequent restoration:
- 1826: United States Government Surveyors; Set 1/4 section post.
Elm 18" N 56° W 160 lks.
Bl. Ash 12" N 07° W 149 lks.
 - 1888: F. Hodgman, County Surveyor; found stake in swamp S 56° E 160 lks. from Elm bearing tree standing, set post.
 - 1907: E. Strong, County Surveyor; found tile.
 - 1909: M.C. Taft, Civil Engineer; found tile.

- B. Description of corner evidence found and/or method applied in restoring or reestablishing corner:
- 1995: Found tile 3" round with "x" on top 8" above surface. Tile is leaning approximately 3" West.

RATIFIED
BY KALAMAZOO COUNTY
REMONUMENTATION
PEER GROUP
9/21/95 *R.E.S.*

- C. Description of monument for corner and accessories established to perpetuate locating the position of the corner:
- I-6: West 1/4 post Section 14, T. 3 S., R. 10 W., Ratified by KCRPPG* on September 21, 1995 and is accepted as a careful and faithful perpetuation of the position of the position of the original corner. Found a 24" section of 3" round tile with "x" on top, as called for in 1888 remonumentation survey by F. Hodgman. Top of tile is 8" above surface and 16" below surface and leaning to West. Placed a remonumentation sleeve over tile.
- | | | | |
|--------------------|-----------|---------|--------|
| PK Nail in N. side | 12" Ash | S 54° W | 24.20' |
| PK Nail in E. side | 12" Maple | N 30° W | 4.87' |
| PK Nail in S. side | 12" Maple | N 76° W | 5.86' |
| PK Nail in S. side | 6" Oak | N 68° E | 6.09' |

Signed by *Robert E. Snell* Date 11-6-95

Surveyor's Michigan License No. 9734

* Kalamazoo County Remonumentation Program Peer Group