

DEC 28 2000

SECTION

LAND CORNER RECORDATION CERTIFICATE
Filing Requirement of Act 74, Mich. P.A. 1970

For corners in

Kalamazoo
(County)
Pavilion Twp.
1. Public Land Survey

| | |
|-------------|---------------|
| Located In: | Corner Code # |
| T 3S R 10W | K-13 |
| T R | |
| T R | |
| T R | |
| S T R | |
| S T R | |
| S T R | |
| S T R | |

2. Property Controlling in Section
3. Miscellaneous Property in Sec.


4. Lot No. _____, Recorded Plat _____
5. Private Claims _____

STATE OF MICHIGAN
COUNTY OF KALAMAZOO
RECEIVED FOR RECORD
96 OCT 18 AM 11 32
CLERK-REGISTER
2 PAGE 069
Register of Deeds Stamp & File Number

I, Robert E. Snell, in a field survey on Feb. 23, 1996 do hereby state that under requirements of P.A. 74, Michigan P.A. of 1970, the corner points mentioned in lines 1 and 2 above were in conformance with regulations and rules therefore as required in the current manual of survey instructions of the United States Department of the Interior, Bureau of Land Management or by a decree of a Court of Law and for that the corner points mentioned in lines 3, 4 and 5 above were in conformance with the rules of the Michigan Board of Land Surveyors or by a Decree of a Court of Law; established, re-established, monumented, recovered, found as expressed below.

NOTE: Not more than 2 corners, all in the same town and range, may be recorded on this certificate.

RATIFIED
BY KALAMAZOO COUNTY
REMONUMENTATION
PEER GROUP 3-21-1996

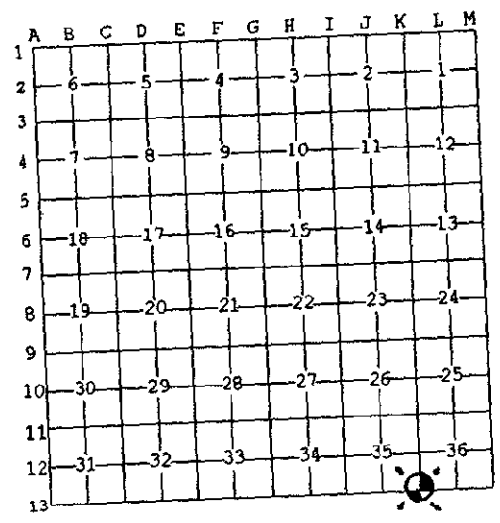

- A. Description of original monument and accessories and/or subsequent restoration:
- 1825: United States Government Surveyors; set post, corner to Sections 35 & 36.
Beech 10" N. 25° W. 14 lks.
Beech 6" N. 65° E. 35 lks.
 - 1884: F. Hodgman, County Surveyor; lost, restored at proportional distance between Southeast corner of Section 36 and South 1/4 post Section 35. Set iron with brick around.
 - 1888: F. Hodgman, County Surveyor; set post.

- B. Description of corner evidence found and/or method applied in restoring or reestablishing corner:
- 1978: Al McMachen, RLS #16935; LCRC, L-1, P-734, tile in monument box.
Power Pole N. 50° W. 76.81' Street Sign N. 40° E. 44.25'
Power Pole S. 30° E. 77.25'
 - 1988: Wilkins & Wheaton Engineering Co.; found tile in monument box in pavement.
PK Nail in Telephone Pole N. 70° W. 76.74'
PK Nail in Root 18" Maple N. 45° W. 51.28'
PK Nail in Telephone Pole S. 35° E. 76.86'
Iron in Monument Box (NW cor. Sec. 1, Brady) East 22.14'

- C. Description of monument for corner and accessories established to perpetuate locating the position of the corner:
- K-13: Southeast corner of Section 35, T. 3 S., R. 10 W., ratified by the Kalamazoo County Remonumentation Program Peer Group on March 21, 1996 and is accepted as a careful and faithful perpetuation of the position of the original corner. Found a tile as set by F. Hodgman in 1888 remonumentation survey in monument box. Placed remonumentation sleeve over tile.
PK Nail in Southeast Root 24" Maple N. 56° E. 51.54'
Nail/Tab in West Side Power Pole S. 34° E. 77.28'
PK Nail in East Side 10" & 6" Maple S. 24° W. 47.15'
PK Nail in South Side Telephone Pole N. 56° W. 76.97'

Signed by Robert E. Snell
Surveyor's Michigan License No. 9734

Date 10-14-96