

SURVEY & REMONUMENTATION

MAY 16 1996

COMMISSION

LAND CORNER RECORDATION CERTIFICATE
Filing Requirement of Act 74, Mich. P.A. 1970

STATE OF MICHIGAN
COUNTY OF KALAMAZOO
RECEIVED FOR RECORD

'96 APR 22 PM 4 23

For corners in
Kalamazoo
(County)
Pavilion Twp.

Located In:

Corner Code #

- | | | |
|--------------------------------------|-------------------|-------|
| 1. Public Land Survey | T 3 S. R 10 W. | L-03 |
| | T ___ R ___ | _____ |
| | T ___ R ___ | _____ |
| | T ___ R ___ | _____ |
| 2. Property Controlling in Section | S ___ T ___ R ___ | _____ |
| | S ___ T ___ R ___ | _____ |
| 3. Miscellaneous Property in Section | S ___ T ___ R ___ | _____ |
| | S ___ T ___ R ___ | _____ |


Jamie Young
CLERK-REGISTER

LIBER 1 PAGE 1478

Register of Deeds Stamp & File Number

4. Lot No. _____, Recorded Plat _____
5. Private Claims _____

I, Robert E. Snell, in a field survey on February 12, 1996, do hereby certify that under requirements of P.A. 74, Michigan P.A. of 1970, the corner points mentioned in lines 1 and 2 above were in conformance with regulations and rules therefore as required in the current manual of survey instructions of the United States Department of the Interior, Bureau of Land Management or by a decree of a Court of Law and/or that the corner points mentioned in lines 3, 4 and 5 above were in conformance with the rules of the Michigan Board of Professional Surveyors or by a Decree of a Court of Law; established, re-established, monumented, re-monumented, recovered, found as expressed below:

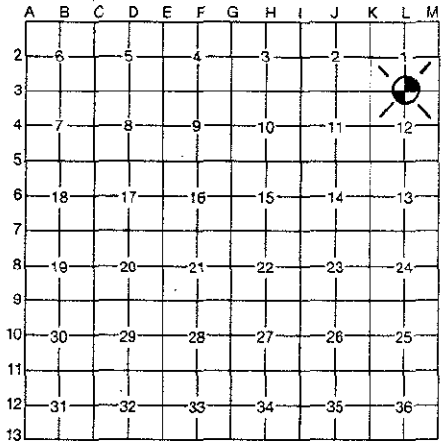

NOTE: Not more than 4 corners, all in the same town and range, may be recorded on this certificate.

A. Description of original monument and accessories and/or subsequent restoration:

1826: United States Government Surveyors; set 1/4 post.

W. Oak 8" N. 19° E. 143 lks.
Tamarack 10" N. 60° W. 112 lks.

1888: F. Hodgman, County Surveyor; found stake in angle of fence S. 19° W., 143 lks. from roots of bearing tree fallen. Set post.

Tamarack 7" N. 33° W. 28 lks.
Tamarack 7" S. 73½° W. 39 lks.

B. Description of corner evidence found and/or method applied in restoring or reestablishing corner:

1974: A. McMachen, R.L.S. #16935; L.C.R.C., L-1, P-732.

L-3, found tile.
15" Maple N. 45° W. 30.32'
Twin 10" Maple N. 45° E. 28.36'
26" Maple S. 10° E. 45.82'

RATIFIED
BY KALAMAZOO COUNTY
REMONUMENTATION
PEER GROUP
3/21/96

1996: Found tile in North and South fence line (down) just below surface with old monument cover nearby.

C. Description of monument for corner and accessories established to perpetuate locating the position of the corner:

L-03: South 1/4 post, Section 1, T. 3 S., R. 10 W., Ratified by the Kalamazoo County Remonumentation Program Peer Group on March 21, 1996 and is accepted as a careful and faithful perpetuation of the position of the original corner. Found 3" round tile with "x" on top as set in 1888 Remonumentation survey by F. Hodgman, County Surveyor. Placed Remonumentation sleeve over tile and placed monument box cover over.

PK Nail in East Side 38" Maple S. 10° E. 45.35'
PK Nail in North Side 22" Double W. Cherry N. 72° W. 32.92'
PK Nail in North Side 22" Maple N. 32° W. 30.32'
PK Nail in North Side 24" Double Maple N. 64° E. 28.00'

Signed by Robert E. Snell Date 4-1-96

Surveyor's Michigan License No. 9734