SURVEY & REMONUMENTATION

FEB 21 2001

SECTION

SURVEY & REMONUMENTATION

FEB 21 2001

SECTION

LAND CORNER RECORDATION CERTIFICATE
Filing Requirement of Act 74, Mich. P.A. 1970

For corners in Pavilion Township

Kalamazoo (County) — Located in: — Corner Code # F-11

1. Public Land Survey — T 3 S R 10 W
2. Property Controlling in Section — S___ T___ R___
3. Miscellaneous Property in Sec. — S___ T___ R___

LC-000117
Page: 1 of 1
09/12/2000 09:18A
Bk-2 Pg-576
LANDCOR-Kalamazoo

Register of Deeds Stamp & File Number

4. Lot No._____, Recorded Plat _____
5. Private Claims

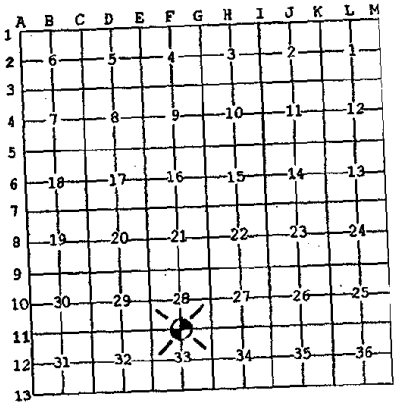

I, Robert E. Snell, in a field survey on July 19, 1999 do hereby state that under requirements of P.A. 74, Michigan P.A. of 1970, the corner points mentioned in lines 1 and 2 above were in conformance with regulations and rules therefore as required in the current manual of survey instructions of the United States Department of the Interior, Bureau of Land Management or by a decree of a Court of Law and/or that the corner points mentioned in lines 3, 4 and 5 above were in conformance with the rules of the Michigan Board of Land Surveyors or by a Decree of a Court of Law; established, re-established, monumented, recovered, found as expressed below:

NOTE: Not more than 2 corners, all in the same town and range, may be recorded on this certificate.

A. Description of original monument and accessories and/or subsequent restoration:

1827: United States Government Surveyors, R. Clark Jr.; set 1/4 post.

Yellow Oak 10" N. 89° E. 203 lks. White Oak 12" S. 81° W. 292 lks.

1888: F. Hodgman, County Surveyor; "'Rock Bounds' by Nutting". Maple 8" S. 39° W. 63 lks.

B. Description of corner evidence found and/or method applied in restoring or reestablishing corner:

1917: M. C. Taft, Engineer; Tile, 8" Maple S. 15 1/2° W. 38.6', 10" Maple N. 3 1/2° E. 40.6', 12" Maple N. 49° W. 69.3'.

1976: A. McMachen, RLS #16935; LCRC L-1, P-597, found iron, 14" Maple S. 10° E. 72.14', 14" Maple S. 20° W. 90.87', 18" Maple N. 15° W. 40.55'.

1999: Found 1 foot piece of tile over stone (18"x10"x8") 3 feet deep in old log road with 1/2" iron at surface and 3/4" iron above. Note: stone and tile have been removed during sewer construction.

C. Description of monument for corner and accessories established to perpetuate locating the position of the corner:

F-11: South 1/4 post, Section 28, T. 3 S., R. 10 W., ratified by the Kalamazoo County Remonumentation Program Peer Group on August 19, 1999 and is accepted as the best available evidence of the position of the original corner. Found stone by Nutting, Surveyor set previous to 1888 Remonumentation survey by F. Hodgman, County Surveyor. Stone and tile removed during sewer construction. Replaced with 20" Harrison monument in monument box after construction.

P.K. Nail in West Side	Power Pole	N. 20° W.	31.78'
P.K. Nail in West Side	Maple	S. 05° W.	71.75'
P.K. Nail in East Side	Maple	N. 15° W.	38.64'
P.K. Nail in West side	Power Pole	S. 48° W.	37.36'

Signed by Robert E. Snell Date Sept. 8, 2000

Surveyor's Michigan License No. 9734

RATIFIED BY KALAMAZOO COUNTY REMONUMENTATION PEER GROUP 8/19/99

FORM APPROVED BY MICHIGAN STATE BOARD OF PROFESSIONAL SURVEYORS, JAN. 28, 197
REVISED MAY 14, 197
REVISED JAN., 198
REVISED OCT., 199