

LAND CORNER RECORDATION CERTIFICATE
Filing Requirement of Act 74, Mich. P.A. 1970

For corners in
KALAMAZOO

(County)

Located In:

Corner Code ~~##~~

- | | | | | | | |
|---------------------------------------|---|-----------|---|------------|------------|-------|
| 1. Public Land Survey | T | <u>3S</u> | R | <u>11W</u> | <u>A-9</u> | |
| | T | _____ | R | _____ | _____ | |
| | T | _____ | R | _____ | _____ | |
| | T | _____ | R | _____ | _____ | |
| 2. Property Controlling in Section | S | _____ | T | _____ | R | _____ |
| | S | _____ | T | _____ | R | _____ |
| 3. Miscellaneous Property in Sec. | S | _____ | T | _____ | R | _____ |
| | S | _____ | T | _____ | R | _____ |

Register of Deeds Stamp & File Number

4. Lot No. _____, Recorded Plat _____
 5. Private Claims _____

I, GARY C. BILOW, in a field survey on AUGUST 15, 19 90, do hereby certify that under requirements of P.A. 74, Michigan P.A. of 1970, the corner points mentioned in lines 1 and 2 above were in conformance with regulations and rules therefore as required in the current manual of survey instructions of the United States Department of the Interior, Bureau of Land Management or by a decree of a Court of Law and/or that the corner points mentioned in lines 3, 4 and 5 above were in conformance with the rules of the Michigan Board of Land Surveyors or by a Decree of a Court of Law; established, re-established, monumented, re-monumented, recovered, found as expressed below:

NOTE: Not more than 4 corners, all in the same town and range, may be recorded on this certificate.

| | A | B | C | D | E | F | G | H | I | J | K | L | M |
|----|----|----|----|----|----|----|---|---|---|---|---|---|---|
| 2 | 6 | 5 | 4 | 3 | 2 | 1 | | | | | | | |
| 3 | | | | | | | | | | | | | |
| 4 | 7 | 8 | 9 | 10 | 11 | 12 | | | | | | | |
| 5 | | | | | | | | | | | | | |
| 6 | 16 | 17 | 16 | 15 | 14 | 13 | | | | | | | |
| 7 | | | | | | | | | | | | | |
| 8 | 19 | 20 | 21 | 22 | 23 | 24 | | | | | | | |
| 9 | | | | | | | | | | | | | |
| 10 | 30 | 29 | 28 | 27 | 26 | 25 | | | | | | | |
| 11 | | | | | | | | | | | | | |
| 12 | 31 | 32 | 33 | 34 | 35 | 36 | | | | | | | |
| 13 | | | | | | | | | | | | | |

A. Description of original monument and accessories and/or subsequent restoration:

CORNER POST ESTABLISHED BY U.S. GOVERNMENT DEPUTY SURVEYOR ROBERT CLARK, 1827, AT A FALLING OF "4 LINKS SOUTH OF POST". ACCESSORIES: W. DAK 20 N80E 69, W. DAK 12 S24E 138. CORNER NOTED ON PAGE 6, BOOK 5 OF 8 OF MICHIGAN STATE HIGHWAY DEPARTMENT PROJECT NO. CS39013RN (DEC. 1959) AS FOUND 1/2" PIPE WITH ACCESSORIES AS FOLLOWS: P. POLE #3935 N59E 54.66', T. POLE #12183 S44E 46.10', LIGHT POLE 548W 68.67'. CORNER ALSO SHOWN ON THE PLAT OF "STAGECOACH TRAILS NO. 2" (REC. LIBER 33 OF PLATS, PAGE 27, KALAMAZOO CO. RECORDS). CORNER RECORDED UNDER ACT 74, P.A. 1970 BY DONALD GILCHRIST, SEPT. 1974, AS "FOUND 1/2" IRON" WITH ACCESSORIES AS FOLLOWS: 2.64' SOUTH OF TEXAS TWP. CORNER, TP 540E 44.18', PP N30E 75.36', PP N45W 107.59'.


B. Description of corner evidence found and/or method applied in restoring or reestablishing corner:

ORIGINAL CORNER POST AND ACCESSORIES NOT RECOVERED. FOUND 1/2" DIA. REINFORCING BAR. POLES REFERENCED IN RECORDATION CERTIFICATE NO LONGER EXIST. FOUND 1/2" REINFORCING BAR NORTH, 2.64' IN ACCORD WITH RECORD. HOWEVER, THE DESIGNATION OF THIS MONUMENT AS A-9 APPEARS TO BE IN CONFLICT WITH: 1) STATED MSHD NOTE. IT APPEARS AS THOUGH MSHD ACCESSORY T. POLE AND RECORD ACCESSORY TP ARE THE SAME POLE AND THAT MSHD MEASUREMENT IS TO THE NORTHERLY CORNER OF THIS STANDARD-CLOSING CORNER PAIR. THIS IS SUPPORTED BY MSHD RIGHT-OF-WAY MAP (US-131 CONTROL SECTION 39013, SHEET 7) DIMENSIONS WHICH YIELD A DISTANCE SOUTH FROM A-7 TO THE NORTHERLY CORNER OF THIS PAIR OF 5339.41'. THIS CHECKS WELL WITH MY MEASURE OF 5339.30'. 2) MY MEASURED DISTANCE BETWEEN A-8 (FND. 1/2" REBAR) AND A-9 CHECKS BETTER TO THE NORTHERLY CORNER (-0.78') THAN THE SOUTHERLY (+1.86') AS COMPARED TO DISTANCE SHOWN ON SAID PLAT. 3) A-8 AS FOUND FALLS EQUIDISTANT BETWEEN A-7 AS RECORDED (LIBER 1, PAGE 591) AND THE NORTHERLY OF THESE TWO CORNERS. ALL THE ABOVE INDICATES THAT THE NORTHERLY REBAR MAY HAVE BEEN ACCEPTED BY OTHERS AS THE SOUTHWEST CORNER OF SECTION 19. NO ATTEMPT WAS MADE ON MY PART TO RESOLVE THIS CONFUSED CORNER. AT THIS TIME, I NEITHER ACCEPT NOR REJECT THE MONUMENTATION FOUND AS OCCUPYING THE LOCATION OF A-9.

C. Description of monument for corner and accessories established to perpetuate locating the position of the corner:

FOUND 1/2" REINFORCING BAR

NORTH 2.64' FOUND 1/2" REINFORCING BAR IN MONUMENT BOX.
 N58W 70.68' SET NAIL AND MICHIGAN DEPT. OF NATURAL RESOURCES TAG IN S. FACE LIGHT POLE
 N39E 40.55' SET NAIL AND MDNR TAG IN W. FACE B" CHINESE ELM
 S25E 54.36' SET NAIL AND MDNR TAG IN W. FACE B" CHINESE ELM

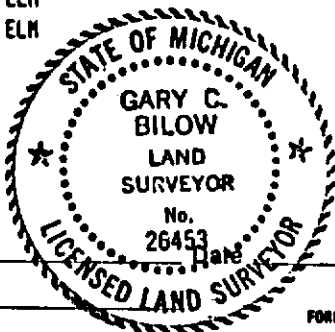

Signed by Gary C. BiLOW
 Surveyor's Michigan License No. 26453

Date 2/8/91