

LAND CORNER RECORDATION CERTIFICATE
Filing Requirement of Act 74, Mich. P.A. 1970

For corners in

Kalamazoo Located In: _____ Corner Code# _____
(County)
City of Portage

1. Public Land Survey T 3S R 11W J6
T _____ R _____
T _____ R _____
T _____ R _____

2. Property Controlling S _____ T _____ R _____
in Section S _____ T _____ R _____

3. Miscellaneous S _____ T _____ R _____
Property in Sec. S _____ T _____ R _____

4. Lot No. _____, Recorded Plat _____
5. Private Claims _____

STATE OF MICHIGAN
COUNTY OF KALAMAZOO
RECEIVED FOR RECORD
98 DEC 23 AM 3 05
Clerk - Register
Register of Deeds Stamp & File Number

I, Gary D. Hahn, in a field survey on August 27, 19 98
do hereby state that under requirements of P.A. 74, Michigan P.A. of 1970, the corner points mentioned in lines 1 and 2 above were in conformance with regulations and rules therefore as required in the current manual of survey instructions of the United States Department of the Interior, Bureau of Land Management or by a decree of a Court of Law and /or that the corner points mentioned in lines 3, 4 and 5 above were in conformance with the rules of the Michigan Board of Land Surveyors or by a Decree of a Court of Law; established, re-established, monumented, recovered, found as expressed below:

NOTE: Not more than 2 corners, all in the same town and range, may be recorded on this certificate.

A. Description of original monument and accessories and/or subsequent restoration:

- Corner not established by original government surveyors.
- KCRC Witness ties:
- (W) Fd. Iron 18" below
- (W) 24" Walnut N 25°E 4.6
- (W) N.E. Cor. Hse. N.W. 76.12
- (W) 42" O. N. 50°E 58.9
- (W) centerline pav. East 27.11
- (N) 12" H. S. 10°W. 14.72
- (W) Fd. Iron same as above
- (W) Conc. Mon. W. 6.67

1946 "Supervisor's plat of Prestler Acres" shows center of section being 6.0' east of SE plat corner.

B. Description of corner evidence found and/or method applied in restoring or reestablishing corner:

1998 - Found plat monument in mon. box 3.1' west of edge of asphalt (Portage Road). Excavated a 4' (E+W) x 6' (N+S) x 6' deep hole. Found no additional monument evidence.

C. Description of monument for corner and accessories established to perpetuate locating the position of the corner:

J-6, Center of Section 14, Town 3 South, Range 11 West, ratified by Kalamazoo County Remonumentation Peer Group on November 19, 1998. This position not established by original government surveyors. The plat monument is accepted as the best available evidence of the position of the corner. Set 30" Harrison Monument in a Monument Box in place of plat monument.

Witness Ties:


- Fnd. Conc. Plat monument west 5.96'
- Set P.K. nail in 18" sassafras west 66.82'
- Set 1/2" rebar @ B/curb S 10°W 24.12'
- Set 1/2" rebar @ front edge of conc. curb in asphalt in driveway opening N 65°E 65.05'

Signed by [Signature]
Surveyor's Michigan License No. 38116

Date 12/08/98
FORM APPROVED BY MICHIGAN STATE BOARD OF PROFESSIONAL SURVEYORS,
JAN. 28, 1971
REVISED MAY 14, 1975
REVISED JAN., 1983 REVISED OCT., 1995

A	B	C	D	E	F	G	H	I	J	K	L	M
1												
2	6		5		4		3		2		1	
3												
4	7		8		9		10		11		12	
5												
6	18		17		16		15		14		13	
7												
8	19		20		21		22		23		24	
9												
10	30		29		28		27		26		25	
11												
12	31		32		33		34		35		36	
13												

RATIFIED
BY KALAMAZOO COUNTY
REMONUMENTATION
PEER GROUP
11/19/98 [Signature]

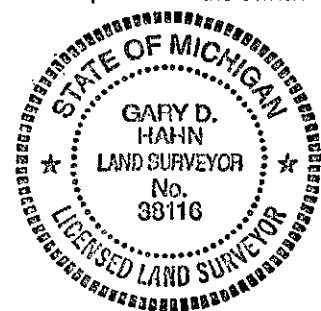

SURVEY &
REMONUMENTATION

FEB 08 1999

SECTION