

**SURVEY & REMONUMENTATION**

FEB 26 1998

7  
2 SECTION

LIBER 2 PAGE 223

**LAND CORNER RECORDATION CERTIFICATE**  
Filing Requirement of Act 74, Mich. P.A. 1970

For corners in

KALAMAZOO  
(County)

Located in: SEC. 1 Corner Code #

- |                                    |  |       |
|------------------------------------|--|-------|
| 1. Public Land Survey              | T <u>3</u> S. R <u>11</u> W.           | M-1   |
|                                    | T <u>   </u> R <u>   </u>              | _____ |
|                                    | T <u>   </u> R <u>   </u>              | _____ |
|                                    | T <u>   </u> R <u>   </u>              | _____ |
| 2. Property Controlling in Section | S <u>   </u> T <u>   </u> R <u>   </u> | _____ |
|                                    | S <u>   </u> T <u>   </u> R <u>   </u> | _____ |
| 3. Miscellaneous Property in Sec.  | S <u>   </u> T <u>   </u> R <u>   </u> | _____ |
|                                    | S <u>   </u> T <u>   </u> R <u>   </u> | _____ |

STATE OF MICHIGAN  
COUNTY OF KALAMAZOO  
RECEIVED FOR RECORD  
197 OCT 24 AM 10 46  
J. E. Stephenson  
CLERK - REGISTER  
Register of Deeds Stamp & File Number

4. Lot No. \_\_\_\_\_, Recorded Plat \_\_\_\_\_  
5. Private Claims \_\_\_\_\_

I, ROGER E. STEPHENSON, in a field survey on OCTOBER 29, 1996 do hereby state that under requirements of P.A. 74, Michigan P.A. of 1970, the corner points mentioned in lines 1 and 2 above were in conformance with regulations and rules therefore as required in the current manual of survey instructions of the United States Department of the Interior, Bureau of Land Management or by a decree of a Court of Law and for that the corner points mentioned in lines 3, 4 and 5 above were in conformance with the rules of the Michigan Board of Land Surveyors or by a Decree of a Court of Law; established, re-established, monumented, recovered, found as expressed below.

	A	B	C	D	E	F	G	H	I	J	K	L	M
1													
2	6		5		4		3		2		1		
3													
4	7		8		9		10		11		12		
5													
6	18		17		16		15		14		13		
7													
8	19		20		21		22		23		24		
9													
10	30		29		28		27		26		25		
11													
12	31		32		33		34		35		36		
13													

NOTE: Not more than 2 corners, all in the same town and range, may be recorded on this certificate.

**A. Description of original monument and accessories and/or subsequent restoration:**

- 1827, ORIGINAL POSITION ESTABLISHED BY JOHN MULLET, D.S.
- 1885, TILE SET BY F. HODGEMAN
- 1960, I.W.M. CALLS FOR BOAT SPIKE  
UNDATED - COUNTY SURVEYORS RECORDS INDICATE SAME
- 1964, I.W.M. CALLS FOR RING & IRON

1972, G.A.I. CALLS FOR RING & IRON  
REFERENCE AT SW CORNER OF MANHOLE  
AS N45°E, 62.86'.

**B. Description of corner evidence found and/or method applied in restoring or reestablishing corner:**


FOUND 1/2" IRON UNDER PAYEMENT  
DUG 4'X4'X4' UNDER THE IRON AND FOUND NORTHING.  
AT 4' DEEP ENCOUNTERED FILL MATERIAL.

**RATIFIED**  
**BY KALAMAZOO COUNTY**  
**REMONUMENTATION**  
**PEER GROUP**  
12-19-1996  
R.E.S.

**C. Description of monument for corner and accessories established to perpetuate locating the position of the corner:**

SET STANDARD MARKER IN PLACE OF FOUND 1/2" BAR

- WITNESSES:  
"+" ON MANHOLE, N43°53'E, 62.29'  
PP, S48°E, 57.15'  
STREET LIGHT, S52°W, 74.14'  
CORNER OLD ENTRANCE, N36°W, 149.75'

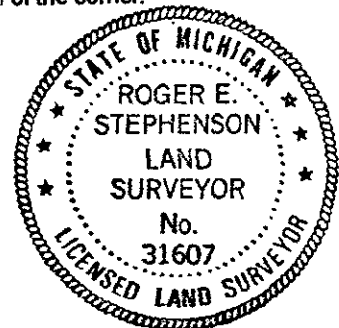

Signed by Roger E. Stephenson  
Surveyor's Michigan License No. 31607

Date 10/23/97