


TEXAS TOWNSHIP  
 SECTION 16, T. 3 S, R. 12 W.  
 COUNTY OF KALAMAZOO, MICH.  
 SCALE - 1" = 1/4 MI.

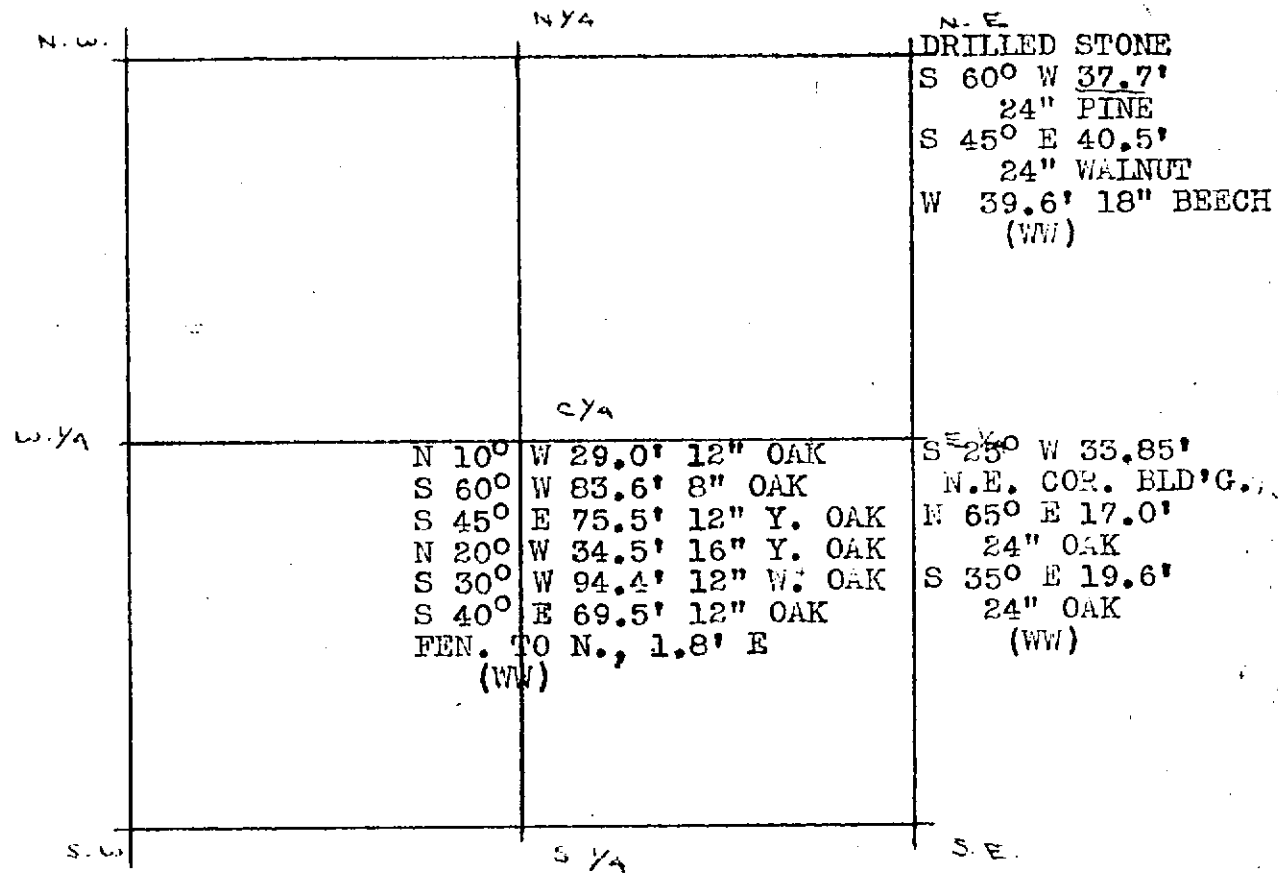

\_\_\_\_\_

\_\_\_\_\_

ACRO ENG. & SURV. INC., KAL., MICH.		
JOB NAME & NO.	DATE	SHEET