

APR 01 1996

COMMISSION

LAND CORNER RECORDATION CERTIFICATE

Filing Requirement of Act 74, Mich. P.A. 1970

STATE OF MICHIGAN
COUNTY OF KALAMAZOO
RECEIVED FOR RECORD

95 DEC 27 AM 10 39

For corners in

Kalamazoo
(County)

Located In:

Corner Code #

Oshkemo Twp.

- 1. Public Land Survey T 2 S R 12 W
- Common with N.W. T R
- Cor. Section 6, T 3 S R 12 W
- Texas Twp.
- 2. Property Controlling S T R
- in Section S T R
- 3. Miscellaneous S T R
- Property in Sec. S T R

A-13
A-1 ✓

James E. Boynton
CLERK-REGISTER

LIBER **1 1423**

Register of Deeds Stamp & File Number

RATIFIED

BY KALAMAZOO COUNTY
REMONUMENTATION
PEER GROUP
4-20-95

- 4. Lot No. _____, Recorded Plat _____
- 5. Private Claims _____

| | A | B | C | D | E | F | G | H | I | J | K | L | M |
|----|----|----|----|----|----|----|---|---|---|---|---|---|---|
| 2 | 6 | 5 | 4 | 3 | 2 | 1 | | | | | | | |
| 3 | | | | | | | | | | | | | |
| 4 | 7 | 8 | 9 | 10 | 11 | 12 | | | | | | | |
| 5 | | | | | | | | | | | | | |
| 6 | 18 | 17 | 16 | 15 | 14 | 13 | | | | | | | |
| 7 | | | | | | | | | | | | | |
| 8 | 19 | 20 | 21 | 22 | 23 | 24 | | | | | | | |
| 9 | | | | | | | | | | | | | |
| 10 | 30 | 29 | 28 | 27 | 26 | 25 | | | | | | | |
| 11 | | | | | | | | | | | | | |
| 12 | 31 | 32 | 33 | 34 | 35 | 36 | | | | | | | |
| 13 | | | | | | | | | | | | | |


I, James E. Boynton, in a field survey on August 18, 1994, do hereby certify that under requirements of P.A. 74, Michigan P.A. of 1970, the corner points mentioned in lines 1 and 2 above were in conformance with regulations and rules therefore as required in the current manual of survey instructions of the United States Department of the Interior, Bureau of Land Management or by a decree of a Court of Law and/or that the corner points mentioned in lines 3, 4 and 5 above were in conformance with the rules of the Michigan Board of Land Surveyors or by a Decree of a Court of Law; established, re-established, monumented, re-monumented, recovered, found as expressed below:

NOTE: Not more than 4 corners, all in the same town and range, may be recorded on this certificate.

- A. Description of original monument and accessories and/or subsequent restoration:
1827, original corner established by William Brookfield, D.S.
1886, corner found and used by A.A. Fosdick, C.S. - no description
1905, W.H. Goss, C.S. found stones from 1886 witnesses
1971, L. Winther found 3/4" pipe
1976, W.Q. Smith found pipe over stone and reset with 1/2" iron bar in mon. box.

B. Description of corner evidence found and/or method applied in restoring or reestablishing corner:
Found 1/2" iron over stone from 1976 witnesses and accepted as best evidence of original corner. Placed Van Buren County standard marker at the direction of the peer group at a meeting on July 27, 1994. Kalamazoo County Peer Group accepted this

- C. Description of monument for corner and accessories established to perpetuate locating the position of the corner:
corner at a meeting on ~~September 21~~, 1995.
April 20
corner is in centerline of road. B
33" Oak S. 20° W. 63.47' to nail
18" Hickory S. 65° W. 34.55' to nail
10" Spruce N. 30° W. 59.41' to nail
14" Oak N. 25° E. 91.05' to nail

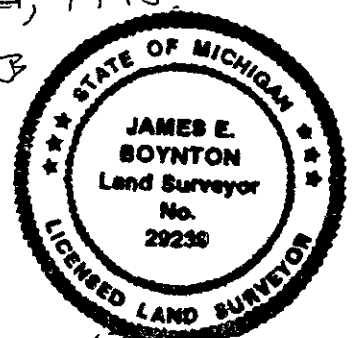

Signed by James E. Boynton
Surveyor's Michigan License No. 29239

Date December 11, 1995