

7. SURVEY &
 2. REMONUMENTATION
 MAY 28 1997
 COMMISSION

LIBER 2 PAGE 096

LAND CORNER RECORDATION CERTIFICATE
 Filing Requirement of Act 74, Mich. P.A. 1970


For corners in Texas Twp.

<u>Kalamazoo</u> (County)	Located In:	Corner Code #
1. Public Land Survey	T3S R12W	C-01
	T R	
	T R	
	T R	
2. Property Controlling in Section	S T R	
	S T R	
3. Miscellaneous Property in Sec.	S T R	
	S T R	

STATE OF MICHIGAN
 COUNTY OF KALAMAZOO
 RECEIVED FOR RECORD
 95 DEC 11 PM 2 51
 REGISTER - REGISTRAR
 Register of Deeds Stamp & File Number

4. Lot No. _____, Recorded Plat _____
 5. Private Claims _____

I, Robert E. Snell, in a field survey on March 21, 1996 do hereby state that under requirements of P.A. 74, Michigan P.A. of 1970, the corner points mentioned in lines 1 and 2 above were in conformance with regulations and rules therefore as required in the current manual of survey instructions of the United States Department of the Interior, Bureau of Land Management or by a decree of a Court of Law and/or that the corner points mentioned in lines 3, 4 and 5 above were in conformance with the rules of the Michigan Board of Land Surveyors or by a Decree of a Court of Law; established, re-established, monumented, recovered, found as expressed below:

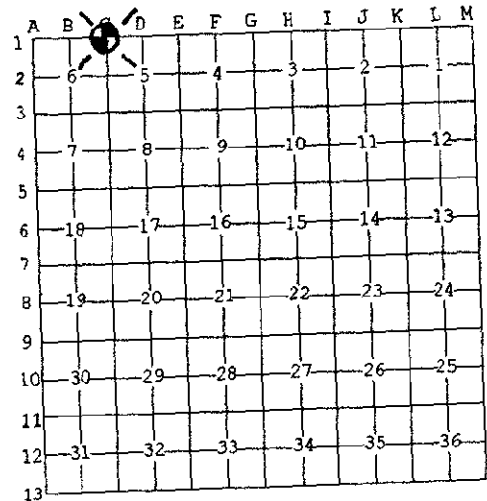

NOTE: Not more than 2 corners, all in the same town and range, may be recorded on this certificate.

- A. Description of original monument and accessories and/or subsequent restoration:
- 1829: United States Government Surveyors; enter North boundary 58 lks. West of post. Set post at intersection, corner of Sections 5 & 6.
 Bl. Oak 24" S. 63¹/₂° E. 184 lks.
 Bl. Oak 6" S. 34° W. 120 lks.
 - 1870: F. Hodgman, County Surveyor; found stake and brick planted by C. J. Monroe (sp?) Surveyor and said by residents to have been kept in place of original corner of which the witnesses are now gone. It is 77 lks. West of the Oshtemo post instead of 58 lks. as given by the Government notes.
- B. Description of corner evidence found and/or method applied in restoring or reestablishing corner:
- 1986: Ingersol, Watson & McMachen; found pipe & bolt for Oshtemo corner (C-13), found broken brick for Texas Corner (C-01). Set iron West 50.82' from Oshtemo corner (C-13).
 - 1996: Found iron/cap over brick.

RATIFIED
 BY KALAMAZOO COUNTY
 REMONUMENTATION
 PEER GROUP
 11-21-1996

C. Description of monument for corner and accessories established to perpetuate locating the position of the corner:
 C-01: Northeast corner Section 6, T. 3 S., R. 12 W., ratified by the Kalamazoo County Remonumentation Program Peer Group on November 21, 1996 and is accepted as a careful and faithful perpetuation of the position of the original corner. Found brick at 50.45' West of Oshtemo corner (C-13) as F. Hodgman found in a survey in 1870 and iron placed by Ingersol, Watson & McMachen in 1986 survey. Placed 30" Harrison monument in place of iron and brick with brick along side monument.

PK Nail in East Root	38" Maple	N. 20° E.	18.25'
PK Nail in Southeast Side	28" Walnut	N. 68° E.	64.39'
PK Nail in East Side	8" Walnut	South	19.92'
Nail/Tab in East Side	Railroad Tie Fence Post	N. 02° W.	11.12'

Signed by Robert E. Snell
 Surveyor's Michigan License No. 9734

Date 12-11-96