

1935

STATE OF MICHIGAN
COUNTY OF KALAMAZOO
RECEIVED FOR RECORD

'95 OCT 19 PM 3 30

LAND CORNER RECORDATION CERTIFICATE
Filing Requirement of Act 74, Mich. P.A. 1970

For corners in **TEXAS TOWNSHIP**

KALAMAZOO Located In: Corner Code #
(County)

1. Public Land Survey	T <u>3</u> S <u>12</u> W	<u>D-11</u>
	T _____ R _____	_____
	T _____ R _____	_____
	T _____ R _____	_____
2. Property Controlling in Section	S _____ T _____ R _____	_____
	S _____ T _____ R _____	_____
3. Miscellaneous Property in Section	S _____ T _____ R _____	_____
	S _____ T _____ R _____	_____


James J. Jump
CLERK-REGISTER

LIBER **1 1360**

Register of Deeds Stamp & File Number

4. Lot No. _____, Recorded Plat _____
5. Private Claims _____

Allen H. McMachen in a field survey on February 16, 19 94, do hereby certify that under requirements of P.A. 74, Michigan P.A. of 1970, the corner points mentioned in lines 1 and 2 above were in conformance with regulations and rules therefore as required in the current manual of survey instructions of the United States Department of the Interior, Bureau of Land Management or by a decree of a Court of Law and/or that the corner points mentioned in lines 3, 4 and 5 above were in conformance with the rules of the Michigan Board of Professional Surveyors or by a Decree of a Court of Law; established, re-established, monumented, re-monumented, recovered, found as expressed below:

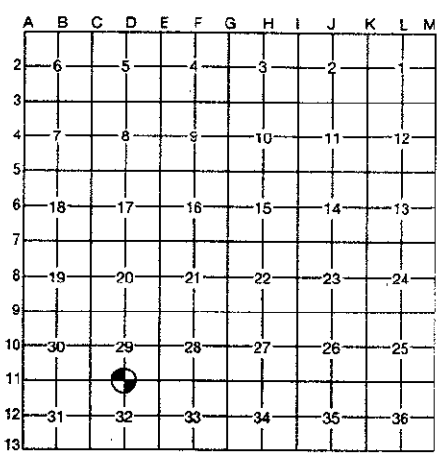

NOTE: Not more than 4 corners, all in the same town and range, may be recorded on this certificate.

A. Description of original monument and accessories and/or subsequent restoration:

- 1829 - E. H. Lytle, D.S., set $\frac{1}{4}$ Sec. Post.
B. Oak 11" N. 58° E. 19 lks.
W. Oak 10" S. 45° W. 27 lks.
- 1878 - F. Hodgeman, C.S., found Stone of former survey.
- 1972 - Smith & Smith, Inc., set Iron, Wits.
4" Hickory S. 10° W. 45.0' to Nail
6" Hickory S. 10° E. 46.29' to Nail
Smith projected through found center Sec. 29 from found N $\frac{1}{4}$ cor., Sec. 29 to set S $\frac{1}{4}$ cor., Sec. 29 (N $\frac{1}{4}$ cor., Sec. 32) and checked by measures to S.W. and S.E. cors. of Sec. 29.*

B. Description of corner evidence found and/or method applied in restoring or reestablishing corner:


Found $\frac{1}{2}$ " Iron Rod in Mon. Box, measured from Iron to N.E. cor. @ 2663.55' and from $\frac{1}{2}$ " Iron to center Sec. 32 @ 2638.38'. Removed Iron and Box and excavated 3' deep and found nothing.

*Measures checked with prorate to Hodgeman measures. Gove. measures N $\frac{1}{4}$ cor. to NE cor. @ 2663.61' (L. 1, Pg. 918) and Kester measures @ 2663.20' (L. 1, Pg. 189). Southwest Survey measures from N $\frac{1}{4}$ cor. to center @ 2638.88' (1. 2, Pg. 131).

RATIFIED
BY KALAMAZOO COUNTY
REMONUMENTATION
PEER GROUP
4-20-95 *R. E. S.*

C. Description of monument for corner and accessories established to perpetuate locating the position of the corner:

Found $\frac{1}{2}$ " Iron is accepted as a careful and faithful re-establishment of the position of the original cor. Placed Harrison Mon. at location of $\frac{1}{2}$ " Iron and placed Mon. Box over. Accessories:
"PK" Nail & Tab in N.E. face U. Pole N. 25° W. 29.44'
"PK" Nail & Tab in N.E. face U. Pole S. 30° E. 61.60'
Nail & Tab in W. Face 6" Elm South 31.55'
Nail & Tab in S.W. Face 6" Oak N. 40° W. 46.00'

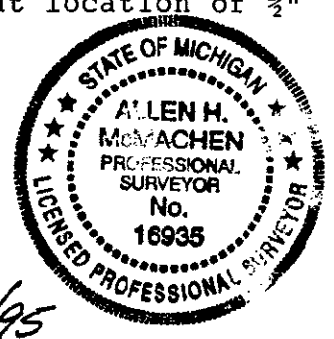

Signed by *Allen H. McMachen*
Surveyor's Michigan License No. 16935

Date 10/18/95