

SURVEY & REMONUMENTATION

MAY 28 1997

COMMISSION

LAND CORNER RECORDATION CERTIFICATE
Filing Requirement of Act 74, Mich. P.A. 1970

For corners in


<u>Kalamazoo</u>	Located In:	Corner Code #	
(County) Texas Twp.			
1. Public Land Survey	T 3S R 12W	E-06	
	T _____ R _____	_____	
	T _____ R _____	_____	
	T _____ R _____	_____	
2. Property Controlling in Section	S _____ T _____ R _____	_____	LIBER
	S _____ T _____ R _____	_____	
3. Miscellaneous Property in Sec.	S _____ T _____ R _____	_____	
	S _____ T _____ R _____	_____	

STATE OF MICHIGAN
COUNTY OF KALAMAZOO
RECEIVED FOR RECORD
96 OCT 18 AM 11
Clerk - Register
Register of Deeds Stamp & Fee Number

4. Lot No. _____, Recorded Plat _____
5. Private Claims _____

I, Robert E. Snell, in a field survey on April 15, 1996 do hereby state that under requirements of P.A. 74, Michigan P.A. of 1970, the corner points mentioned in lines 1 and 2 above were in conformance with regulations and rules therefore as required in the current manual of survey instructions of the United States Department of the Interior, Bureau of Land Management or by a decree of a Court of Law and /or that the corner points mentioned in lines 3, 4 and 5 above were in conformance with the rules of the Michigan Board of Land Surveyors or by a Decree of a Court of Law, established, re-established, monumented, recovered, found as expressed below.

NOTE: Not more than 2 corners, all in the same town and range, may be recorded on this certificate.

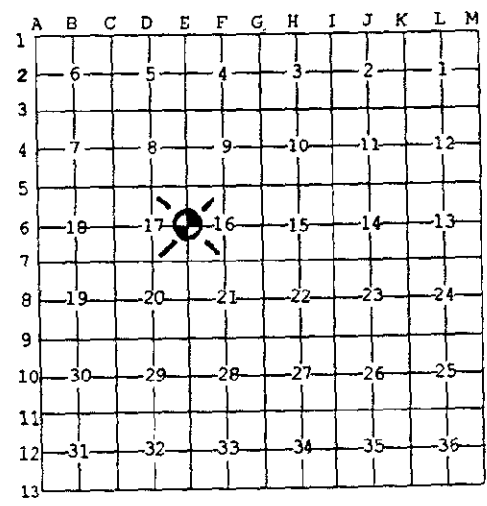

- A. Description of original monument and accessories and/or subsequent restoration:
- 1829: United States Government Surveyors; set 1/4 Section post.
Blk. Oak 9" N. 47° E. 30 lks.
W. Oak 14" S. 50° W. 4 lks.
 - 1898: Ed Strong, County Surveyor; found stone set in former survey.

RATIFIED
BY KALAMAZOO COUNTY
REMONUMENTATION
PEER GROUP
6-20-1996

- B. Description of corner evidence found and/or method applied in restoring or reestablishing corner:
- 1940: Wilkins & Wheaton Engr. Co.; found stone, placed iron over and under. Oak in fence line South 39.25' in North & South fence line
36" Oak N. 20° E. 63.3'
 - 1974: Donald Gilchrist, R.L.S. #13583; L.C.R.C. L-1, P-521, hole in blue stone 2' deep. N & C in 48" Oak N. 20° E. 64.50' N & C in 20" Oak N. 55° E. 18.30'
N & C in 40" Oak South 38.93' Metal Post (MBT) N. 45° W. 23.4'+
 - 1989: Tom Chettleburgh, R.L.S. #16036; L.C.R.C. L-1, P-920, notch in blue stone 2' deep/ railroad spikes around.
Nail/Tag in NW side 30" Oak N. 55° E. 77.09'
Nail/Tag in NE side 11" Oak S. 45° E. 42.79'
Nail/Cap in 40" Oak South 39.22'

- C. Description of monument for corner and accessories established to perpetuate locating the position of the corner:
- E-06: West 1/4 post Section 16, T. 3 S., R. 12 W., ratified by the Kalamazoo County Remonumentation Program Peer Group on June 20, 1996 and is accepted as a careful and faithful perpetuation of the position of the original corner. Found 12"x8"x8" blue stone with drill hole, 1 foot + deep with railroad spikes around. Stone was found and accepted by Ed Strong in 1898 survey. Removed stone and placed a 30" Harrison monument in its place.
PK Nail in West side Power Pole S. 10° E. 10.50'
Exist. Nail/Tab in West side 42" Oak S. 02° W. 39.37'
Exist. Nail/Tab in East side 12" Oak S. 50° E. 42.85'
Exist. Nail/Tab in West side 34" Oak N. 56° E. 76.93'

Signed by Robert E. Snell
Surveyor's Michigan License No. 9734

Date 10-17-96