

SURVEY & REMONUMENTATION

APR 27 1995

COMMISSION

LAND CORNER RECORDATION CERTIFICATE
Filing Requirement of Act 74, Mich. P.A. 1970

STATE OF MICHIGAN
COUNTY OF KALAMAZOO
RECEIVED FOR RECORD

95 JAN 17 PM 12 39

For corners in

Kalamazoo

(County)

Located In:

Corner Code #

Texas Township

1. Public Land Survey

T 3 S R 12 W

E-9

T _____ R _____

T _____ R _____

T _____ R _____

2. Property Controlling
in Section

S _____ T _____ R _____

S _____ T _____ R _____

3. Miscellaneous

S _____ T _____ R _____

Property in Sec.

S _____ T _____ R _____

4. Lot No. _____, Recorded Plat _____

5. Private Claims _____

James J. [Signature]

CLERK-REGISTER


LIBER **1** PG **1263**

Register of Deeds Stamp & File Number

I, Robert E. Snell, in a field survey on May 16, 19 94,

do hereby certify that under requirements of P.A. 74, Michigan P.A. of 1970, the corner points mentioned in lines 1 and 2 above were in conformance with regulations and rules therefore as required in the current manual of survey instructions of the United States Department of the Interior, Bureau of Land Management or by a decree of a Court of Law and/or that the corner points mentioned in lines 3, 4 and 5 above were in conformance with the rules of the Michigan Board of Land Surveyors or by a Decree of a Court of Law; established, re-established, monumented, re-monumented, recovered, found as expressed below:

NOTE: Not more than 4 corners, all in the same town and range, may be recorded on this certificate.

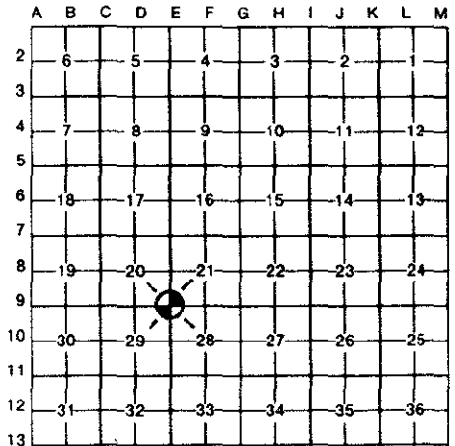

A. Description of original monument and accessories and/or subsequent restoration:

1829: U.S. Government Survey; Set Post. Corner to Sections 20, 21, 28 and 29 on a
White Oak 16"

1878: F.Hodgman, County Surveyor; Corner tree cut down. Drove stake in hollow of the stump and marked;

W. Oak 24" South 40° West 66 Lks
Bl. Oak 8" South 05° West 76 Lks

1917: M.C. Taft, Surveyor; Found stone at Southwest Corner of Section 21.

B. Description of corner evidence found and/or method applied in restoring or reestablishing corner:

1994: Found 1" iron in monument box. Below iron found stone with "X" on top along with one piece of tile along side of stone.

**RATIFIED
BY KALAMAZOO COUNTY
REMONUMENTATION
PEER GROUP**

9/15/94 *R. E. Snell*

C. Description of monument for corner and accessories established to perpetuate locating the position of the corner:

E-9 Southeast Corner Section 20, T. 3 S., R. 12 W., Ratified by the Kalamazoo County Remonumentation Program Peer Group on September 15, 1994. Found stone with notched "X" on top as called for by M.C. Taft in 1917 survey and is accepted as a careful and faithful perpetuation of the position of the original corner. Removed stone and placed a 20" Harrison monument and monument box in it's place.

Centerline of "R" Avenue	North	6.0'
"X" Notched in East Side (3' High) Chain Link Fence Corner	North 07° West	34.26'
PK Nail in Westerly Side 24" Oak	North 56° East	35.93'
PK Nail in Easterly Side 26" Oak	South 24° East	39.61'
PK Nail in West Side 19" Maple	South 30° West	37.51'

Signed by

Robert E. Snell

Date

1-17-95

Surveyor's Michigan License No.

9734