

SURVEY & REMONUMENTATION

FEB 18 1994

COMMISSION

**KALAMAZOO COUNTY - REMONUMENTATION
LAND CORNER RECORDATION CERTIFICATE
Filing Requirement of Act 74, Mich. P.A. 1970**

STATE OF MICHIGAN
COUNTY OF KALAMAZOO
RECEIVED FOR RECORD
'93 NOV 11 AM 8 54

For corners in

<u>Kalamazoo</u> (County)	Located In:	Corner Code #:
1. Public Land Survey	T <u>3S</u> R <u>12W</u>	E-13
	T _____ R _____	SE Cor.
	T _____ R _____	Sec. 32
	T _____ R _____	Texas Twp.
2. Property Controlling in Section	S _____ T _____ R _____	
	S _____ T _____ R _____	
3. Miscellaneous Property in Sec.	S _____ T _____ R _____	
	S _____ T _____ R _____	

James P. ...
CLERK-REGISTER

LIBER 1 PG 1015
Register of Deeds Stamp & File Number

4. Lot No. _____, Recorded Plat _____
5. Private Claims _____

	A	B	C	D	E	F	G	H	I	J	K	L	M
2	6	5	4	3	2	1							
3													
4	7	8	9	10	11	12							
5													
6	13	17	16	15	14	13							
7													
8	19	20	21	22	23	24							
9													
10	30	29	28	27	26	25							
11													
12	31	32	33	34	35	36							
13													

I, Thomas W. Chettleburgh, in a field survey on October 15, 1993, do hereby certify that under requirements of P.A. 74, Michigan P.A. of 1970, the corner points mentioned in lines 1 and 2 above were in conformance with regulations and rules therefore as required in the current manual of survey instructions of the United States Department of the Interior, Bureau of Land Management or by a decree of a Court of Law and/or that the corner points mentioned in lines 3, 4 and 5 above were in conformance with the rules of the Michigan Board of Land Surveyors or by a Decree of a Court of Law; established, re-established, monumented, re-monumented, recovered, found as expressed below:


NOTE: Not more than 4 corners, all in the same town and range, may be recorded on this certificate.

A. Description of original monument and accessories and/or subsequent restoration:
Strong 1901, Found Stone
Kalamazoo County Witnesses
Oak 24" N75°E 22.7'
Ash 8" N40°W 15.3'
Ash 18" S75°W 11.4'
W.Cherry N75°E 6.4'

B. Description of corner evidence found and/or method applied in restoring or reestablishing corner:
Dug found nothing, area has been cleared and on edge of a gravel pit.
Set corner at government measure (69 lks) East of NE corner Section 5, T4S, R12W, and on line with said NE corner of Section 5 and the South 1/4 Corner Section 32, T3S, R12W.
25" Ash S85°W 12.27'
Set 4" X 30" Harrison Monument

**RATIFIED
BY KALAMAZOO COUNTY
REMONUMENTATION
PEER GROUP**

C. Description of monument for corner and accessories established to perpetuate locating the position of the corner:
4" X 30" Harrison Monument
NE Cor. Sec. 5, T4S, R12W, (4" Harrison Monument) West 45.54'
Spike E side Tw 26" Oak S28°W 92.25'
Spike N side 25" Ash S85°W 12.27'
Spike S side 11" Oak N77°W 77.32'
Spike SW side 16" Oak N65°W 55.27'

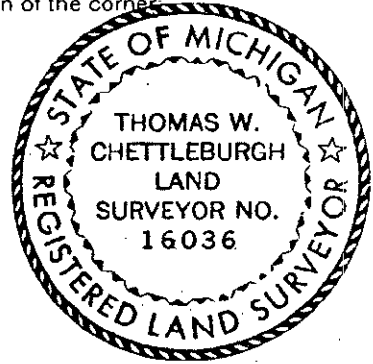

Signed by Thomas W. Chettleburgh Date November 8, 1993
Surveyor's Michigan License No. 16036