

SURVEY & REMONUMENTATION

LIBER **1** PG **1155**

APR 27 1995

COMMISSION

LAND CORNER RECORDATION CERTIFICATE
Filing Requirement of Act 74, Mich. P.A. 1970

For corners in

<u>Kalamazoo</u> <small>(County)</small>	Located In:	Corner Code #
<u>Texas Township</u>		
1. Public Land Survey	T <u>3S</u> R <u>12W</u>	<u>F-1</u>
	T _____ R _____	_____
	T _____ R _____	_____
	T _____ R _____	_____
2. Property Controlling in Section	S _____ T _____ R _____	_____
	S _____ T _____ R _____	_____
3. Miscellaneous Property in Sec.	S _____ T _____ R _____	_____
	S _____ T _____ R _____	_____
4. Lot No. _____, Recorded Plat _____		
5. Private Claims _____		

STATE OF MICHIGAN
 COUNTY OF KALAMAZOO
 RECEIVED FOR RECORD
 1994 JUL 6 AM 11 52
 CLERK - REGISTER

Register of Deeds Stamp & File Number

I, Thomas W. Chettleburgh, in a field survey on March 22, 1994, do hereby certify that under requirements of P.A. 74, Michigan P.A. of 1970, the corner points mentioned in lines 1 and 2 above were in conformance with regulations and rules therefore as required in the current manual of survey instructions of the United States Department of the Interior, Bureau of Land Management or by a decree of a Court of Law and/or that the corner points mentioned in lines 3, 4 and 5 above were in conformance with the rules of the Michigan Board of Land Surveyors or by a Decree of a Court of Law; established, re-established, monumented, re-monumented, recovered, found as expressed below:

NOTE: Not more than 4 corners, all in the same town and range, may be recorded on this certificate.

A	B	C	D	E	F	G	H	I	J	K	L	M
2	6	5	4	3	2	1						
3												
4	7	8	9	10	11	12						
5												
6	13	17	16	15	14	13						
7												
8	19	20	21	22	23	24						
9												
10	30	29	28	27	26	25						
11												
12	31	32	33	34	35	36						
13												

A. Description of original monument and accessories and/or subsequent restoration:

Corner Post not set by U.S. Government Land Surveys
 Ed Strong, 1913, established corner position at average falling of 159 lks (104.94'), did not set post. (Strong measured fallings of 128 lks to West & 190 lks to East)
 J. Stack, 1980's, set corner at average falling of 137.5 lks (90.75') according to recorded GLO fallings of 128 lks to West & 147 lks to East.
 D. Erickson, 1992, found corner set by J. Stack, recorded LCRC, Liber 1, Page 975.


B. Description of corner evidence found and/or method applied in restoring or reestablishing corner:

Set corner on township line at 104.94' East of the S 1/4 corner of Sec. 33, T2S, R12W, as established by Ed Strong in 1913. This corner position was accepted as a careful and faithful perpetuation of the corner position as established by Ed Strong in 1913 and was ratified by the Kalamazoo County Remonumentation Program Peer Group on April 21, 1994.
 Found corner stake as set by J. Stack & described and recorded by D. Erickson 0.28' North of Township Line & 14.19' West of approved corner position.
 Set 30" Harrison Monument at approved corner position.

RATIFIED
BY KALAMAZOO COUNTY
REMONUMENTATION
PEER GROUP
 4-21-94

C. Description of monument for corner and accessories established to perpetuate locating the position of the corner:

30" Harrison Monument
 4" Diameter Harrison Monument (S 1/4 Cor. Sec. 33, T2S, R12W) N87°W 104.94'
 Spike NE side 16" W. Cherry N54°W 55.66'
 Spike NW side 19" Oak N43°E 8.45'
 Spike W side 10" Oak S6°W 30.30'
 Spike N side 30" Oak S85°W 27.56'

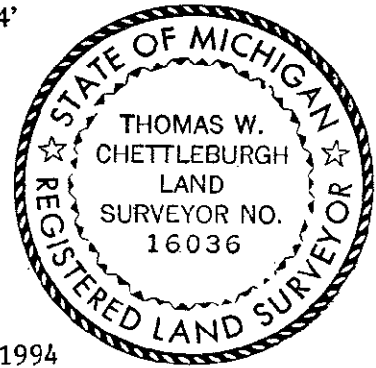

Signed by Thomas W. Chettleburgh Date July 5, 1994
 Surveyor's Michigan License No. 16036