

SURVEY & REMONUMENTATION

APR 27 1995

COMMISSION

LAND CORNER RECORDATION CERTIFICATE
Filing Requirement of Act 74, Mich. P.A. 1970

STATE OF MICHIGAN
COUNTY OF KALAMAZOO
RECEIVED FOR RECORD
94 DEC 30 PM 2 39

For corners in


<u>Kalamazoo</u> <small>(County)</small>	Located In:	Corner Code #	
Texas Township			
1. Public Land Survey	T <u>3S</u> R <u>12W</u>	<u>F-2</u>	
	T _____ R _____	_____	
	T _____ R _____	_____	
	T _____ R _____	_____	
2. Property Controlling in Section	S _____ T _____ R _____	_____	
	S _____ T _____ R _____	_____	
3. Miscellaneous Property in Sec.	S _____ T _____ R _____	_____	
	S _____ T _____ R _____	_____	

Jessie Young
CLERK-REGISTER

LIBER 1 PG 1245

Register of Deeds Stamp & File Number

4. Lot No. _____, Recorded Plat _____
5. Private Claims _____

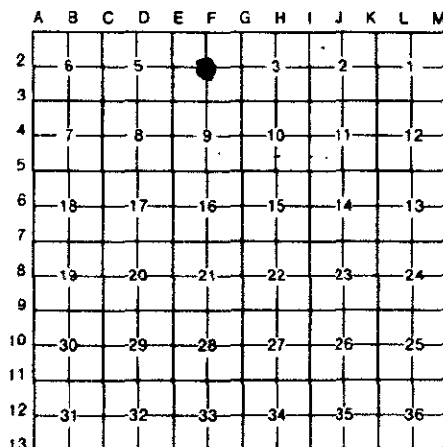

Thomas W. Chettleburgh, in a field survey on December 2, 1994, do hereby certify that under requirements of P.A. 74, Michigan P.A. of 1970, the corner points mentioned in lines 1 and 2 above were in conformance with regulations and rules therefore as required in the current manual of survey instructions of the United States Department of the Interior, Bureau of Land Management or by a decree of a Court of Law and/or that the corner points mentioned in lines 3, 4 and 5 above were in conformance with the rules of the Michigan Board of Land Surveyors or by a Decree of a Court of Law; established, re-established, monumented, re-monumented, recovered, found as expressed below:

NOTE: Not more than 4 corners, all in the same town and range, may be recorded on this certificate.

A. Description of original monument and accessories and/or subsequent restoration:
 Corner Post not set by U.S. Government Land Surveys.
 Ed Strong 1913, Held intersection of 1/4 lines, did not set post.
 John Kester 1970, Held straight line between 1/4 corners for E-W 1/4 line.
 John Slack 1986, Held intersection of 1/4 lines for center, did not set post.
 John Erickson 1992, Held intersection of 1/4 lines for center, did not set post.


B. Description of corner evidence found and/or method applied in restoring or reestablishing corner:
 Set center of Section at intersection of 1/4 lines.
 North 1/4 corner N00°14'16"W 2807.33'
 East 1/4 corner N89°46'52"E 2638.72'
 South 1/4 corner S00°14'16"E 2650.45'
 West 1/4 corner S89°46'52"W 2644.45'

RATIFIED
BY KALAMAZOO COUNTY
REMONUMENTATION
PEER GROUP
4-21-94

This corner position was accepted as a careful and faithful perpetuation of the corner position as established by Ed Strong in 1913 and was ratified by the Kalamazoo County Remonumentation Program Peer Group on April 21, 1994.

Set 30" Harrison Monument at approved corner position.

C. Description of monument for corner and accessories established to perpetuate locating the position of the corner:
 30" Harrison Monument
 Spike SE side 30" Oak N40°E 12.86'
 Spike SE side 12" Oak N65°E 36.59'
 Spike W side 18" Oak Due South 27.98'
 Spike NE side 16" Oak N57°W 46.36'
 Spike SW side 12" Hickory N30°W 18.19'
 Fence corner 4.5' North & 11.5' East

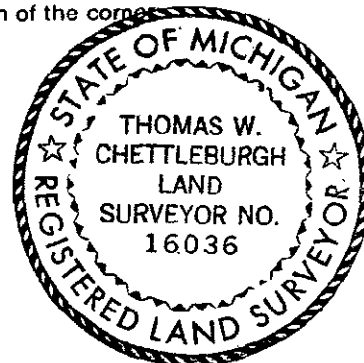

Signed by *Thomas W. Chettleburgh*
 Surveyor's Michigan License No. 16036

Date December 22, 1994