

SURVEY & REMONUMENTATION

APR 27 1995

COMMISSION LAND CORNER RECORDATION CERTIFICATE
 Filing Requirement of Act 74, Mich. P.A. 1970

STATE OF MICHIGAN
 COUNTY OF KALAMAZOO
 RECEIVED FOR RECORD

JAN 17 PM 12 39

For corners in

Kalamazoo
 (County)

Located In:

Corner Code #

Texas Township

1. Public Land Survey

T 3 S R 12 W

F-9

T R

T R

T R

2. Property Controlling in Section

S T R

S T R

3. Miscellaneous Property in Sec.

S T R

S T R

4. Lot No. , Recorded Plat

5. Private Claims

James Young
 CLERK-REGISTER


LIBER 1 PG 1262

Register of Deeds Stamp & File Number

I, Robert E. Snell, in a field survey on May 16, 1994,

do hereby certify that under requirements of P.A. 74, Michigan P.A. of 1970, the corner points mentioned in lines 1 and 2 above were in conformance with regulations and rules therefore as required in the current manual of survey instructions of the United States Department of the Interior, Bureau of Land Management or by a decree of a Court of Law and/or that the corner points mentioned in lines 3, 4 and 5 above were in conformance with the rules of the Michigan Board of Land Surveyors or by a Decree of a Court of Law; established, re-established, monumented, re-monumented, recovered, found as expressed below:

NOTE: Not more than 4 corners, all in the same town and range, may be recorded on this certificate.

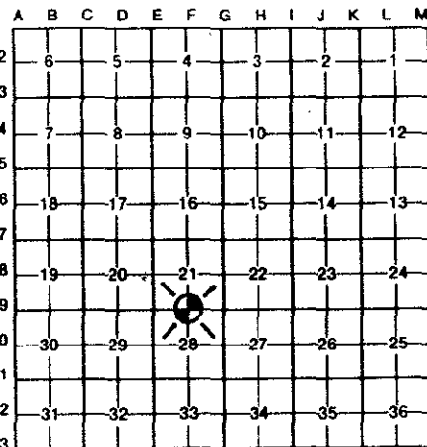

A. Description of original monument and accessories and/or subsequent restoration:

1829: U.S. Government Survey; Set 1/4 Section Post.

Hickory 6" South 20 1/2° West 15 Lks
 Bl. Oak 9" North 51° West 40 Lks

1871: F. Hodgman, County Surveyor; Found stone set by Hatch, correct by his witness stumps marked;

Yellow Oak 12" North 32 1/2° West 59 Lks
 Hickory 10" South 09 1/2° East 43 Lks

1917: M.C. Taft, Surveyor; Found stone.

B. Description of corner evidence found and/or method applied in restoring or reestablishing corner:
 1948: Wilkins & Wheaton Engineering; Large stone placed iron above 16" Hickory N 01° E 24.8'
 E & W Fence North 24.1'
 Fence runs North on line
 24" Elm S 60° E

1994: Found 5/8" diameter iron in monument box.

Found 1' diameter stone about 1 1/2' below surface with notched "X".

RATIFIED
BY KALAMAZOO COUNTY
REMONUMENTATION
PEER GROUP
 9/15/94 *R. E. Snell*

C. Description of monument for corner and accessories established to perpetuate locating the position of the corner:

F-9 South 1/4 Post Section 21, T. 3 S., R. 12 W., Ratified by the Kalamazoo County Remonumentation Program Peer Group on September 15, 1994. Found stone with notched "X" as called for in 1871 resurvey by F.Hodgman and 1948 survey by Wilkins & Wheaton Engineering Company and is accepted as a careful and faithful perpetuation of the position of the original corner. Placed 30" Harrison monument and monument box over stone.

Exist. Nail/Tab in Railroad Tie Fence Corner South 12° East 22.00'
 Iron/Cap (13165) North 33.03'
 PK Nail in West Side 10" Dogwood South 40° West 38.93'
 PK Nail in West Side 12" Hickory North 40° West 39.78'

Signed by

Robert E. Snell

Date

1-17-95

Surveyor's Michigan License No. 9734