SURVEY & REMONUMENTATION

APR 27 1995

COMMISSION

LIBER 1 PG 1161

STATE OF MICHIGAN
COUNTY OF KALAMAZOO
RECEIVED FOR RECORD
'94 JUL 6 AM 11 52

CLERK-REGISTER

LAND CORNER RECORDATION CERTIFICATE
Filing Requirement of Act 74, Mich. P.A. 1970

For corners in

Kalamazoo (County)

Texas Township

		Located In:	Corner Code #
1. Public Land Survey		T 3S R 12W	G-3
		T ___ R ___	
		T ___ R ___	
		T ___ R ___	
2. Property Controlling	S ___	T ___ R ___	
in Section	S ___	T ___ R ___	
3. Miscellaneous	S ___	T ___ R ___	
Property in Sec.	S ___	T ___ R ___	

Register of Deeds Stamp & File Number

4. Lot No. _____ , Recorded Plat _____
5. Private Claims _____

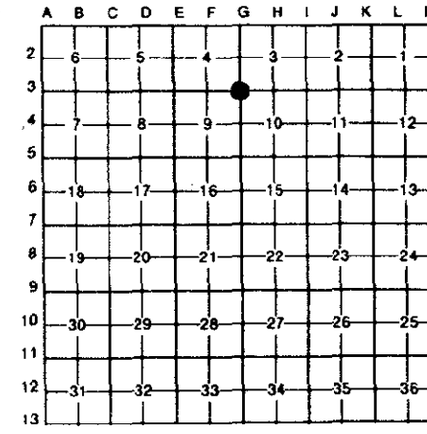

I, Thomas W. Chettleburgh, in a field survey on March 22, 19 94, do hereby certify that under requirements of P.A. 74, Michigan P.A. of 1970, the corner points mentioned in lines 1 and 2 above were in conformance with regulations and rules therefore as required in the current manual of survey instructions of the United States Department of the Interior, Bureau of Land Management or by a decree of a Court of Law and/or that the corner points mentioned in lines 3, 4 and 5 above were in conformance with the rules of the Michigan Board of Land Surveyors or by a Decree of a Court of Law; established, re-established, monumented, re-monumented, recovered, found as expressed below:

NOTE: Not more than 4 corners, all in the same town and range, may be recorded on this certificate.

A. Description of original monument and accessories and/or subsequent restoration:

Corner Post set by U.S. Government Deputy Surveyor Thom Whelpley, 1829.
Accessories: Burr Oak 10" N54°E 13, W.Oak 24" S85 1/4°W 52.
Kalamazoo County Witness Sheet, 1943, Found stone with cross on top, brought to surface with iron.
MDOT 1957, 1/2" iron bar.
Accessories: 24" Maple N62°W 56.88', Power pole S32°E 68.87', 20" Oak S10°W 113.58'.
Gove 1963, pencil iron. ?
J. Budzik 1973, d Set iron over stone with chiseled "X".
T. Chettleburgh 1988, Found 1/2" iron bar, Recorded LCRC Liber 1, Page 886.

B. Description of corner evidence found and/or method applied in restoring or reestablishing corner:

Original Corner Post & Accessories not recovered.
Found 1/2" iron bar in monument box directly over stone with chiseled "X" 1.3' deep.
Checks corner location as described by MDOT, Gove & J. Budzik, and as described and recorded by T. Chettleburgh.
Centerline E-W road South 1.0', Centerline N-S road West 1.5'.
The 1/2" iron bar over stone with chiseled "X" was accepted as a careful and faithful perpetuation of the position of the original corner and was ratified by the Kalamazoo County Remonumentation Program Peer Group on April 21, 1994.
Set 15" Harrison Monument and monument box directly over the stone with chiseled "

RATIFIED BY KALAMAZOO COUNTY REMONUMENTATION PEER GROUP 4-21-94

C. Description of monument for corner and accessories established to perpetuate locating the position of the corner:

15" Harrison Monument in monument box.

Spike NE side	Power Pole	S29°E	68.79'
Nail/Tag E side	30" Oak	S12°W	113.46'
Nail/Tag N side	19" Hickory	S75°W	86.12'
Nail/Tag S side	33" Maple	N59°W	56.11'
Nail/Tag E side	12" Walnut	N12°W	103.70'

STATE OF MICHIGAN
THOMAS W. CHETTLEBURGH
LAND SURVEYOR NO. 16036
REGISTERED LAND SURVEYOR

Signed by Thomas W. Chettleburgh Date July 5, 1994

Surveyor's Michigan License No. 16036

FORM APPROVED BY MICHIGAN STATE BOARD OF LAND SURVEYORS, JAN. 28, 1971
REVISED MAY 14, 1975
REVISED JAN., 1983