

1/ SURVEY 221  
 7 REMONUMENTATION  
 AUG 22 1995  
 COMMISSION

**LAND CORNER RECORDATION CERTIFICATE**  
**Filing Requirement of Act 74, Mich. P.A. 1970**

For corners in

Kalamazoo (County) Located In: \_\_\_\_\_ Corner Code # \_\_\_\_\_  
Texas Township  
 1. Public Land Survey T 3 S R 12 W H-2  
 T \_\_\_\_\_ R \_\_\_\_\_  
 T \_\_\_\_\_ R \_\_\_\_\_  
 T \_\_\_\_\_ R \_\_\_\_\_  
 2. Property Controlling S \_\_\_\_\_ T \_\_\_\_\_ R \_\_\_\_\_  
 in Section S \_\_\_\_\_ T \_\_\_\_\_ R \_\_\_\_\_  
 3. Miscellaneous S \_\_\_\_\_ T \_\_\_\_\_ R \_\_\_\_\_  
 Property in Sec. S \_\_\_\_\_ T \_\_\_\_\_ R \_\_\_\_\_

STATE OF MICHIGAN  
 COUNTY OF KALAMAZOO  
 RECEIVED FOR RECORD  
 95 APR 24 PM 3 32  
 Clerk - Register  
*[Signature]*

Register of Deeds Stamp & File Number

4. Lot No. \_\_\_\_\_, Recorded Plat \_\_\_\_\_  
 5. Private Claims \_\_\_\_\_  
 LIBER **1 1289**

A	B	C	D	E	F	G	H	I	J	K	L	M
2	6	5	4				●	2		1		
3												
4	7	8	9	10	11	12						
5												
6	18	17	16	15	14	13						
7												
8	19	20	21	22	23	24						
9												
10	30	29	28	27	26	25						
11												
12	31	32	33	34	35	36						
13												


I, Robert E. Snell, in a field survey on April 3, 19 95, do hereby certify that under requirements of P.A. 74, Michigan P.A. of 1970, the corner points mentioned in lines 1 and 2 above were in conformance with regulations and rules therefore as required in the current manual of survey instructions of the United States Department of the Interior, Bureau of Land Management or by a decree of a Court of Law and/or that the corner points mentioned in lines 3, 4 and 5 above were in conformance with the rules of the Michigan Board of Land Surveyors or by a Decree of a Court of Law; established, re-established, monumented, re-monumented, recovered, found as expressed below:

**NOTE: Not more than 4 corners, all in the same town and range, may be recorded on this certificate.**

- A. Description of original monument and accessories and/or subsequent restoration:  
 This position not established by original government surveyors.  
 1866: Stimson, County Surveyor; established Center 1/4, a Sonte-other notes obliterated.  
 1870: F. Hodgman, County Surveyor; referenced as established by Stimson.  
 1874; E. Strong, County Surveyor; referenced as established by Stimson.

- B. Description of corner evidence found and/or method applied in restoring or reestablishing corner:  
 1944: Wilkins & Wheaton Engineering Company, Inc.; Found stone.  
 1947: Wilkins & Wheaton Engineering Company, Inc.; Found stone.  
 1995: Wilkins & Wheaton Engineering, Robert Snell, County Surveyor; Found stone 2.6" North of South R.O.W. Fence to I-94.

**RATIFIED**  
**BY KALAMAZOO COUNTY**  
**REMONUMENTATION**  
**PEER GROUP**  
 4-20-95  
*[Signature]*

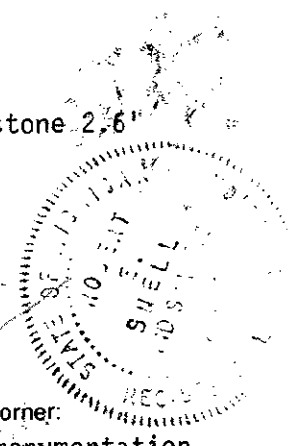

C. Description of monument for corner and accessories established to perpetuate locating the position of the corner:  
 H-2 Center of Section 3, T. 3 S., R. 12 W., Ratified by the Kalamazoo County Remonumentation Program Peer Group on April 20, 1995. Found stone with cross as mentioned in 1866 survey by Stimson and is accepted as the best available evidence of the position of the corner. Lowered stone and placed a 30" Harrison monument over stone.

(MSHD) Nail/Tab	in South Side	4" Sassafras	North 30° West	12.57'
(Jensen) Nail/Tab	in North Side	6" Hickory	North 05° West	34.00'
(MSHD) Nail/Tab	in South Side	12" Cottonwood	North 60° East	17.85'
(Jensen) Nail/Tab	in West Side	26" Oak	South 05° East	37.09'
PK Nail	in South Side	16" Oak	South 60° West	36.40'

Signed by *Robert E. Snell* Date 4-24-95  
 Surveyor's Michigan License No. 9734