

LAND CORNER RECORDATION CERTIFICATE

Filing Requirement of Act 74, Mich. P.A. 1970

For corners in TEXAS TWP
KALAMAZOO
(County)

Located In:

Corner Code #

1. Public Land Survey	T	<u>3S.</u>	R	<u>12W.</u>	<u>I-6</u>
	T		R		
	T		R		
	T		R		
2. Property Controlling in Section	S		T	R	
	S		T	R	
3. Miscellaneous Property in Section	S		T	R	
	S		T	R	

LIBER PAGE 365

CLERK - REGISTER

Janice Johnson


'98 OCT 22 PM 1 22

STATE OF MICHIGAN
COUNTY OF KALAMAZOO
RECEIVED FOR RECORD

Register of Deeds Stamp & File Number

4. Lot No. _____, Recorded Plat _____
5. Private Claims _____
6. IWM Job No. 24130

I, Allen H. McMachen, in a field survey on September, 1998 do hereby certify that under requirements of P.A. 74, Michigan P.A. of 1970, the corner points mentioned in lines 1 and 2 above were in conformance with regulations and rules therefore as required in the current manual of survey instructions of the United States Department of the Interior, Bureau of Land Management or by a decree of a Court of Law and/or that the corner points mentioned in lines 3, 4 and 5 above were in conformance with the rules of the Michigan Board of Professional Surveyors or by a Decree of a Court of Law; established, re-established, monumented, re-monumented, recovered, found as expressed below:

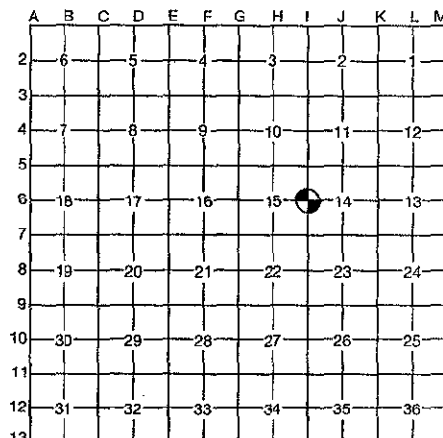

NOTE: Not more than 4 corners, all in the same town and range, may be recorded on this certificate.

A. Description of original monument and accessories and/or subsequent restoration:

- 1829 - E.H. Lytle, D.S., Set quarter Section post, Wh. Oak 13" S. 85½° E. 38 lks., Wh. Oak 11" N. 88° W. 14 lks..
- 1911 - G. Wheaton, C.S., Set West quarter corner on bisection of West line of Section.
- 1931 - Kalamazoo County Road Commission, Records show iron rod placed near West quarter corner for road P.I.
- 1953 - Kalamazoo County Surveyor, Indicates iron on line between Southwest corner and Northwest corner at ±½ mile North of Southwest corner and opposite fence to West. Also indicates meas. from iron to Southwest corner at 2635.23 feet and meas. from iron to Center quarter corner at 2623.79 feet.

B. Description of corner evidence found and/or method applied in restoring or reestablishing corner:

Found concrete monument on West edge of pavement. Measured South 2635.25 feet to standard marker at Southwest corner and measured North 2635.10 feet to iron rod at Northwest corner. Found monument is 0.07 feet East of a straight line between the Southwest corner and the Northwest corner. Also measured East 2623.91 feet to ½" I.D. pipe at Center quarter corner. Found iron in monument box ±14 feet Easterly in paved roadway is believed to be the Road Commission P.I. iron.

NOV 25 1998

SECTION

RATIFIED
BY KALAMAZOO COUNTY
REMONUMENTATION
PEER GROUP
10-15-1998 *K. 2.8*

C. Description of monument for corner and accessories established to perpetuate locating the position of the corner:

Found concrete monument is accepted as the best available evidence of the position of the original corner. Replaced concrete monument with a 30" Harrison Monument with monument box over, Accessories::

- Nail & Tab in East side 18" Maple N. 07° W. 79.05'
- Nail & Tab in South side 22" Oak S. 73° W. 16.02'
- Nail & Tab in West side 30" Oak S. 20° W. 60.60'
- Nail & Tab in East side 34" Oak S. 22° E. 99.82'
- Centerline of top bolt hydrant S. 65° E. 45.40'



Signed by *Allen H. McMachen*
Surveyor's Michigan License No. 16935

Date 10/21/98