

SURVEY & REMONUMENTATION

APR 27 1995

COMMISSION

LAND CORNER RECORDATION CERTIFICATE
Filing Requirement of Act 74, Mich. P.A. 1970

STATE OF MICHIGAN
COUNTY OF KALAMAZOO
RECEIVED FOR RECORD
30 PM 2 40

For corners in

<u>Kalamazoo</u> <small>(County)</small>	Located In	Corner Code #
Texas Township		
1. Public Land Survey	T 3S R 12W	I-7
	T _____ R _____	_____
	T _____ R _____	_____
	T _____ R _____	_____
2. Property Controlling in Section	S _____ T _____ R _____	_____
	S _____ T _____ R _____	_____
3. Miscellaneous Property in Sec.	S _____ T _____ R _____	_____
	S _____ T _____ R _____	_____
4. Lot No. _____, Recorded Plat _____		
5. Private Claims _____		


[Signature]

CLERK-REGISTER

LIBER 1 PG 1248

Register of Deeds Stamp & File Number

Thomas W. Chettleburgh, in a field survey on November 3, 1994, do hereby certify that under requirements of P.A. 74, Michigan P.A. of 1970, the corner points mentioned in lines 1 and 2 above were in conformance with regulations and rules therefore as required in the current manual of survey instructions of the United States Department of the Interior, Bureau of Land Management or by a decree of a Court of Law and/or that the corner points mentioned in lines 3, 4 and 5 above were in conformance with the rules of the Michigan Board of Land Surveyors or by a Decree of a Court of Law; established, re-established, monumented, re-monumented, recovered, found as expressed below:

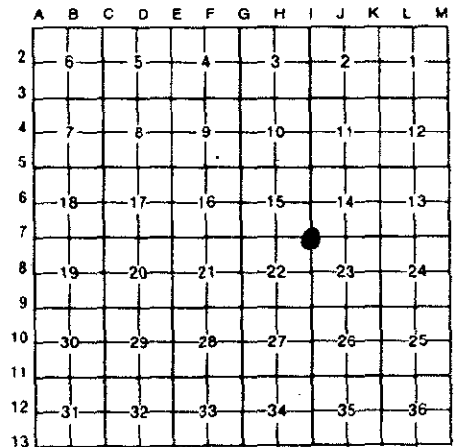

NOTE: Not more than 4 corners, all in the same town and range, may be recorded on this certificate.

A. Description of original monument and accessories and/or subsequent restoration:
 Corner Post set by U.S. Government Deputy Surveyor Thos Whelpley 1829
 Accessories: 26" W. Oak N46 1/4° W 1.23 chains, 20" Bl. Oak S57.1° E 2.49 chains
 Ed Strong 1870, Corner lost. Set stone with cross from 1/4 section lines.
 Ed Strong 1911 Set post with brick using 1870 witnesses.
 Wilkins & Wheaton 1949, Set iron.
 McMachen 1972, Record L.C.R.C. Liber 1, Page 101.
 Wilkins & Wheaton 1992, Restore iron in monument box after sewer construction.

B. Description of corner evidence found and/or method applied in restoring or reestablishing corner:
 Original corner post and accessories not recovered.
 Found iron in monument box as described and recorded by McMachen and as restored by Wilkins & Wheaton.
 The iron in monument box was accepted as a careful and faithful perpetuation of the position of the original corner and was ratified by the Kalamazoo County Remonumentation Program Peer Group on December 15, 1994.
 Replaced iron in monument box with 20" Harrison Monument.

RATIFIED
 BY KALAMAZOO COUNTY
 REMONUMENTATION
 PEER GROUP
 12-15-94
[Signature]

C. Description of monument for corner and accessories established to perpetuate locating the position of the corner:
 20" Harrison Monument in monument box

Centerline hydrant	N40°E	49.89'
Spike in SW side Power Pole	S37°E	39.37'
Spike in NW side Power Pole	S55°W	49.50'
Centerline 24" dia. manhole	S65°W	6.70'
Centerline monitoring well	N20°W	69.67'



Signed by *[Signature]*
 Surveyor's Michigan License No. 16036

Date December 22, 1994