

NOV 2 1998

SECTION

LAND CORNER RECORDATION CERTIFICATE

Filing Requirement of Act 74, Mich. P.A. 1970

For corners in TEXAS TWP KALAMAZOO (County)

Located In:

Corner Code #

Table with 4 rows and 4 columns: Survey Type, T, R, Corner Code #. Row 1: Public Land Survey, T, 3S, R, 12W, K-5.

LIBER

2 PAGE 367

CLERK - REGISTER

Handwritten signature

98 OCT 22 PM 1 22

STATE OF MICHIGAN COUNTY OF KALAMAZOO RECEIVED FOR RECORD

Register of Deeds Stamp & File Number

- 4. Lot No.
5. Private Claims
6. IWM Job No. 24130

Grid table with columns A-L and rows 2-13. A dot is marked at row 5, column J.

I, Allen H. McMachen, in a field survey on September, 1998, do hereby certify that under requirements of P.A. 74, Michigan P.A. of 1970, the corner points mentioned in lines 1 and 2 above were in conformance with regulations and rules therefore as required in the current manual of survey instructions of the United States Department of the Interior, Bureau of Land Management or by a decree of a Court of Law and/or that the corner points mentioned in lines 3, 4 and 5 above were in conformance with the rules of the Michigan Board of Professional Surveyors or by a Decree of a Court of Law; established, re-established, monumented, re-monumented, recovered, found as expressed below:

NOTE: Not more than 4 corners, all in the same town and range, may be recorded on this certificate.

A. Description of original monument and accessories and/or subsequent restoration:

- 1829 - E.H. Lytle, D.S., Corner Sec. 11, 12, 13 & 14 on Wh. Oak 12".
1960 - W.D. Ingersoll, R.L.S., N. 30° E. 3.02' to 1/2" iron stake, S. 15° W. 14" Walnut 79.0', S. 60° W. T. Pole 64.0', S. 45° E. 30" Maple 44.5', N. 60° E. 8" Walnut 33.8'.
1964 - Wilkins & Wheaton, Measured from Northeast corner, Section 14 East 1300.44 feet to eighth corner and continued East 1300.10 feet to South quarter corner
1967 - W.D. Ingersoll, R.L.S., Found iron rod at Northeast corner Section 14, and meas. East 1300.4 feet to found iron and stone at eighth corner and continued East 1300.1 feet to found stone at South quarter corner of Section 12. A straight line between the Northeast corner, Section 14 and the South quarter corner, Section 12 is 0.5 feet North of found eighth corner.

B. Description of corner evidence found and/or method applied in restoring or reestablishing corner:


Found iron rod in monument box. Measured East 1300.65 feet to 1/2" iron and stone at eighth corner and continued East 1299.96 feet to found 1/2" iron rod at South quarter corner, Section 12 (position ratified 8/20/98). A straight line between found iron at Northeast corner, Section 14 and the South quarter corner, Section 12 is 0.39 feet North of found eighth corner. Found iron at Northeast corner, Section 14 also matches (3) 1960 witnesses. Removed iron and box and dug to depth of 4.5 feet and probed an additional 1.5 feet and found no additional evidence of corner.

RATIFIED BY KALAMAZOO COUNTY REMONUMENTATION PEER GROUP 10-15-1998

C. Description of monument for corner and accessories established to perpetuate locating the position of the corner:

Position of found iron rod is accepted as the best available evidence of the position of the original corner. Replaced found iron rod with a 20" Harrison Monument, Accessories:

- Nail & Tab in SE side 25" Walnut N. 55° E. 33.45'
Nail & Tab in North side 42" Maple S. 40° E. 44.7'
Nail & Tab in SE side 34" Walnut S. 25° W. 78.9'
Nail & Tab in East side 15" Walnut N. 32° W. 37.18'

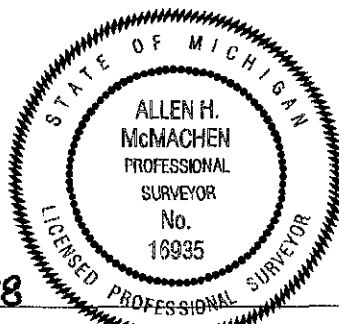

Signed by [Signature] Surveyor's Michigan License No. 10935

Date 10/22/98