

**SURVEY & REMONUMENTATION**

OCT 06 1997

COMMISSION

**LAND CORNER RECORDATION CERTIFICATE**  
**Filing Requirement of Act 74, Mich. P.A. 1970**

LIBER 2 PAGE 176

For corners in Texas Township Located In: \_\_\_\_\_ Corner Code # \_\_\_\_\_  
Kalamazoo (County)

|                                      |   |     |   |      |     |
|--------------------------------------|---|-----|---|------|-----|
| 1. Public Land Survey                | T | 3S. | R | 12W. | K-9 |
|                                      | T |     | R |      |     |
|                                      | T |     | R |      |     |
|                                      | T |     | R |      |     |
| 2. Property Controlling in Section   | S |     | T | R    |     |
|                                      | S |     | T | R    |     |
| 3. Miscellaneous Property in Section | S |     | T | R    |     |
|                                      | S |     | T | R    |     |

CLERK - REGISTER

*Annell Johnson*

STATE OF MICHIGAN  
 COUNTY OF KALAMAZOO  
 RECEIVED FOR RECORD  
 '97 JUL 29 PM 3 57  
 Register of Deeds Stamp & File Number

4. Lot No. \_\_\_\_\_, Recorded Plat \_\_\_\_\_  
 5. Private Claims \_\_\_\_\_  
 6. IWM JOB NO. 28120

|    |    |    |    |    |    |    |   |   |   |   |   |   |
|----|----|----|----|----|----|----|---|---|---|---|---|---|
| A  | B  | C  | D  | E  | F  | G  | H | I | J | K | L | M |
| 2  | 6  | 5  | 4  | 3  | 2  | 1  |   |   |   |   |   |   |
| 3  |    |    |    |    |    |    |   |   |   |   |   |   |
| 4  | 7  | 8  | 9  | 10 | 11 | 12 |   |   |   |   |   |   |
| 5  |    |    |    |    |    |    |   |   |   |   |   |   |
| 6  | 18 | 17 | 16 | 15 | 14 | 13 |   |   |   |   |   |   |
| 7  |    |    |    |    |    |    |   |   |   |   |   |   |
| 8  | 19 | 20 | 21 | 22 | 23 | 24 |   |   |   |   |   |   |
| 9  |    |    |    |    |    |    |   |   |   |   |   |   |
| 10 | 30 | 29 | 28 | 27 | 26 | 25 |   |   |   |   |   |   |
| 11 |    |    |    |    |    |    |   |   |   |   |   |   |
| 12 | 31 | 32 | 33 | 34 | 35 | 36 |   |   |   |   |   |   |
| 13 |    |    |    |    |    |    |   |   |   |   |   |   |

I, Allen H. McMachen in a field survey on June 17, 1997, do hereby certify that under requirements of P.A. 74, Michigan P.A. of 1970, the corner points mentioned in lines 1 and 2 above were in conformance with regulations and rules therefore as required in the current manual of survey instructions of the United States Department of the Interior, Bureau of Land Management or by a decree of a Court of Law and/or that the corner points mentioned in lines 3, 4 and 5 above were in conformance with the rules of the Michigan Board of Professional Surveyors or by a Decree of a Court of Law; established, re-established, monumented, re-monumented, recovered, found as expressed below:

**NOTE: Not more than 4 corners, all in the same town and range, may be recorded on this certificate.**

**A. Description of original monument and accessories and/or subsequent restoration:**

- 1829 - E. H. Lytle, D.S., Set post corner, Secs 23, 24, 25 & 26, Br. Oak 8" S. 3/4° W. 187 lks., Br. Oak 26" N. 44° W. 375 lks.  
1879 - F. Hodgman, C.S., "Found iron stake which Eale Douglass and A.B. Hill testify to be in place of the original stake." Wh. Oak 8" S. 75° W. 87 1/2 lks., Hickory 8" S. 34° W. 90 lks.

**B. Description of corner evidence found and/or method applied in restoring or reestablishing corner:**


Found iron rod in monument box. Excavated 4 1/2' below monument box and found nothing. Replaced iron and box, 6' East and 1' North of box had indication of another marker. Dug through road and found flat iron 8" below road surface surrounded by broken brick. Brick was found to ±30" deep. Measure West from found flat iron to 1/8 line fence occupation North at 1333 feet and continued West 1333 feet to stone at South quarter corner.

**RATIFIED**  
**BY KALAMAZOO COUNTY**  
**REMONUMENTATION**  
**PEER GROUP**  
 7-16-1997 *R. E. S.*

**C. Description of monument for corner and accessories established to perpetuate locating the position of the corner:**

Found flat iron is accepted as a careful and faithful perpetuation of the position of the original corner. Removed found iron and replaced with Harrison monument with monument box over, Accessories:

- Nail & Tab in 10" Twin Oak N. 45° E. 51.73'  
 Nail & Tab in P. Pole S. 35° E. 93.54'  
 Nail & Tab in P. Pole S. 60° W. 167.81'  
 Nail & Tab in P. Pole N. 30° W. 73.83'

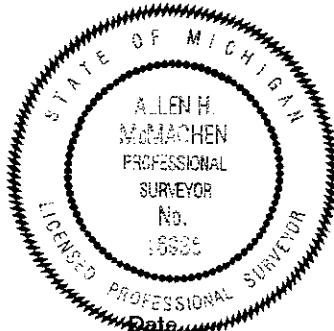

Signed by *Allen H. McMachen*

*7/25/97*

Surveyor's Michigan License No. 16935