

LAND CORNER RECORDATION CERTIFICATE

Filing Requirement of Act 74, Mich. P.A. 1970

STATE OF MICHIGAN  
COUNTY OF KALAMAZOO  
RECEIVED FOR RECORD

'95 AUG 31 AM 11 35

For corners in

KALAMAZOO  
(County)

Located In:

Corner Code #

WAKESHMA TWP.

1. Public Land Survey	T	<u>4</u>	R	<u>9</u>	<u>C5</u>
	T		R		
	T		R		
	T		R		
2. Property Controlling in Section	S		T		
	S		T		
3. Miscellaneous Property in Section	S		T		
	S		T		

*[Signature]*

CLERK-REGISTER

LIBER

1 **1341**

Register of Deeds Stamp & File Number

- 4. Lot No. \_\_\_\_\_, Recorded Plat \_\_\_\_\_
- 5. Private Claims \_\_\_\_\_

I, GARY D. HAHN, in a field survey on MAY 1, 1995, do hereby certify that under requirements of P.A. 74, Michigan P.A. of 1970, the corner points mentioned in lines 1 and 2 above were in conformance with regulations and rules therefore as required in the current manual of survey instructions of the United States Department of the Interior, Bureau of Land Management or by a decree of a Court of Law and/or that the corner points mentioned in lines 3, 4 and 5 above were in conformance with the rules of the Michigan Board of Professional Surveyors or by a Decree of a Court of Law; established, re-established, monumented, re-monumented, recovered, found as expressed below:

**NOTE: Not more than 4 corners, all in the same town and range, may be recorded on this certificate.**

A	B	C	D	E	F	G	H	I	J	K	L	M
2	6		5	4		3		2				
3												
4	7		8	9		10		11		12		
5		●										
6	18		17	16		15		14		13		
7												
8	19		20	21		22		23		24		
9												
10	30		29	28		27		26		25		
11												
12	31		32	33		34		35		36		
13												


A. Description of original monument and accessories and/or subsequent restoration:

Corner post established by U.S. Government Deputy Surveyor Robert Clark, Jr. in 1826.

Accessories: Beech 13in. N63°W 20 ½ lks.  
Beech 15in. S8°E 25lks.

B. Description of corner evidence found and/or method applied in restoring or reestablishing corner:

Original corner with accessories not recovered.  
Fnd. 5/8" dia. x 18" long pipe in centerline of roads.  
Fnd. 25" long cedar stake against south edge of pipe just below 8" thick asphalt road. Found very small chunks of brick around stake 20" below road.

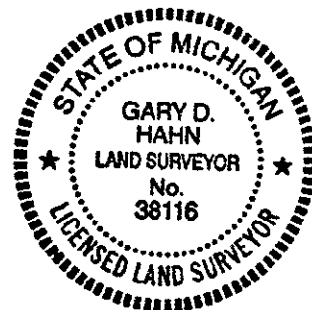

**RATIFIED**  
**BY KALAMAZOO COUNTY**  
**REMONUMENTATION**  
**PEER GROUP**  
6-15-95 *[Signature]*

C. Description of monument for corner and accessories established to perpetuate locating the position of the corner:

C5, Southeast corner section 7, T4S-R9W, Ratified by Kalamazoo County Remonumentation Peer Group on June 15, 1995. Found 5/8" dia. pipe is accepted as the best available evidence of the position of the original corner.

- Removed pipe & set 30" Harrison Monument in monument box.
- Found P.K. Nail in Power Pole S38°W 61.42'
- Set P.K. Nail in 27" Sycamore S48°W 42.72'
- Set P.K. Nail in wood fence post N2°W 33.30'
- Set P.K. Nail in 10" Oak N45°W 35.35'
- Set P.K. Nail in 4" Oak N38°E 33.69'

Signed by *[Signature]*

Date August 7, 1995

Surveyor's Michigan License No. 38116